IREDELL COUNTY HEALTH DEPARTMENT

Statesville Phone TR 3-7271 — Mooresville Phone MC 3-1271

PERMIT TO INSTALL SEPTIC TANK

Permit NO. 1 — Permit Date July 31, 1959

Owner F L York — Address

Installed By C S T WALT — Address


Location of Property UP #20 TO WHITE OAK - LEFT - THEN 1st RIGHT - PASS SHILO CHURCH 1st HOUSE ON RIGHT

Tank		Capacity		Length of Lines		Fixtures	
Block	(✓)	800	( )	150'	(✓)	No. of Baths	(1)
Precast	( )	900	( )	175'	( )	Dishwasher	( )
		1000	(✓)	200'	( )	Garbage Grdr.	( )
		1100	( )	225'	( )	Auto-Washer	( )
		1200	( )	250'	( )	Other	
		Other		Other			

NOTIFY HEALTH DEPARTMENT AT LEAST EIGHT HOURS BEFORE TANK IS TO BE INSPECTED.

Final Inspection July 31, 1959 — Approved (✓) Disapproved ( )

Remarks FARM - 6000 JOB -

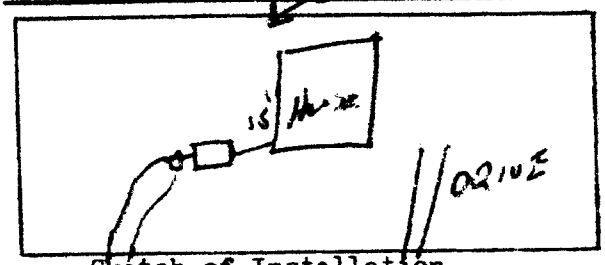

Sketch of Installation

Raford A. Thomas

Sanitarian