IREDELL COUNTY HEALTH DEPARTMENT

Statesville Office (704) 878-5305 Mooresville Office (704) 660-3625 PERMIT # 21172

IMPROVEMENT PERMIT / AUTHORIZATION TO CONSTRUCT / OPERATION PERMIT / EXISTING SYSTEM

PIN # 4703564453

APPLICANT: Troutman Family LTDP APPLICANT ADDRESS: 232 Davie Ave.

SITE ADDRESS: 106 Adkins Lane PHONE: 704-873-5233 ALT. PHONE: N/A

SITE DIRECTIONS: Hwy 70W TR Shady Rest Rd TR Adkins Ln 1st Lot on Right

SUBDIVISION: Morrow Meadows SECTION: N/A LOT # 45+46 LOT AREA: 0.511 acres DESIGN FLOW: 360gpd L.T.A.R.: 0.25


Septic Tank	1000 (gal)	STB	760-1000	Date	8-17	☑ New System	☐ Repair	☐ Expansion	System Type: I II (III) IV V VI	☑ Residence	No. Bedrooms 3
Pump Tank	(gal)	PT		Date		System Description:	25% Reduction			☐ Business	No. Persons 6
Pump Make		Model		Serial #		Repair System Description:	50% Reduction			☐ Other	No. Employees
# Nitrification Fields	1	# Lines	4	Linear Ft:	360	Maintenance Agreement Required:	☐ YES	☑ NO		☐ Slab	☑ Crawl Space
Trench Width	36"	Max. Trench Bottom Depth	36"	Gravel Depth	N/A		☑ GRAVITY	☐ PRESSURE		☐ Basement w/plumbing	☐ Basement w/o plumbing

Water Supply: ☐ Private ☑ Public ☐ Community


Comments / Conditions: IMPROVEMENTS ONLY. Combine + record lots and submit floor plan prior to issuance of CA. Install a 25% Reduction system on contour w/ serial distribution

* Install trench bottoms @ 36" on high side *

INITIAL SITE SKETCH

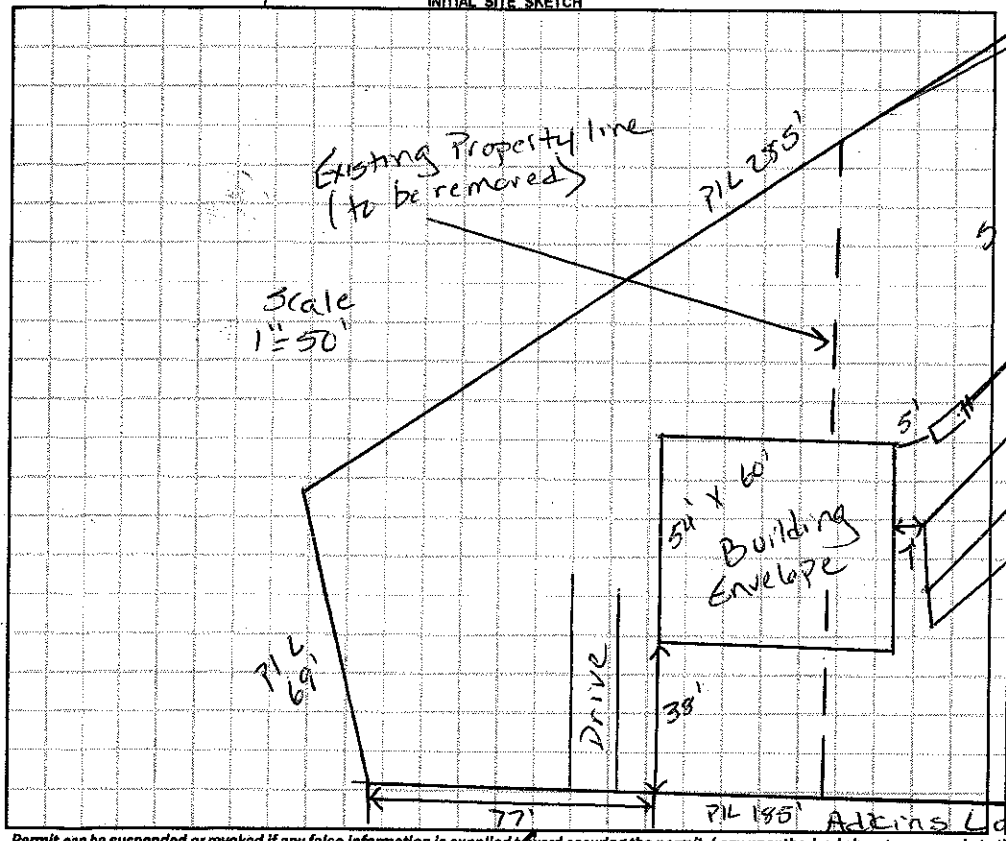

AS BUILT SKETCH

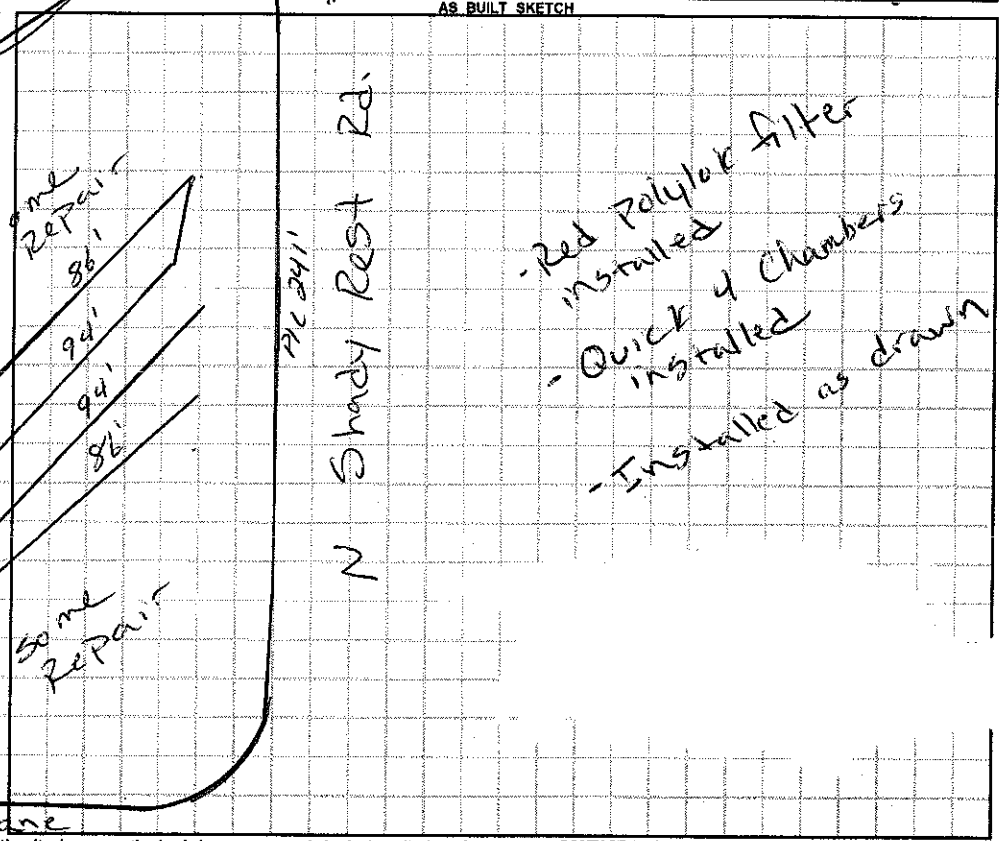

Permit can be suspended or revoked if any false information is supplied toward securing the permit / any unauthorized changes are made to the site / any unauthorized changes are made in the installation of the system. **CONTACT A LOCATOR SERVICE PRIOR TO ANY EXCAVATION**

☐ **IMPROVEMENT PERMIT** *with plat valid without expiration.* ☐ **IMPROVEMENT PERMIT** *with site plan valid for 60 mos.* ☑ **AUTHORIZATION TO CONSTRUCT** *valid for period equal to IMPROVEMENT PERMIT--not to exceed 60 mo.*

Owner / Applicant Signature: [signature] Date: 8-5-15 Installed by: Bryant Contracting

IMPROVEMENT PERMIT by: Justin Henderson Date: 8-13-15 OPERATION PERMIT by: Justin Henderson Date: 2-1-16

AUTHORIZATION TO CONSTRUCT by: Justin Henderson Date: 1-6-16 Existing System Inspected by: Date:

Health Dept. Copy - WHITE Applicant (Final Approval) - YELLOW Applicant (Conditional Approval) - PINK