IREDELL COUNTY HEALTH DEPARTMENT

Statesville Office (704) 878-5305 Mooresville Office (704) 660-3625 PERMIT # 211723

IMPROVEMENT PERMIT / AUTHORIZATION TO CONSTRUCT / OPERATION PERMIT / EXISTING SYSTEM

PIN # 4703565750

APPLICANT: Troutman Family LTD? APPLICANT ADDRESS: 232 Davie Ave.

SITE ADDRESS: 114 Adkins Ln. PHONE: 704-873-5233 ALT. PHONE: N/A


SITE DIRECTIONS: Hwy 70 W TR Shady Rest Rd. TR Adkins Ln. 2nd Lot on Right

SUBDIVISION: Morrow Meadows SECTION: N/A LOT # 44 LOT AREA: 0.786 acres DESIGN FLOW: 360gpd L.T.A.R.: 0.275

Septic Tank	1000 (gal)	STB 760	Date 9-12	☑ New System ☐ Repair ☐ Expansion	System Type: I II (III) IV V VI	☑ Residence	No. Bedrooms	3	Water Supply
Pump Tank	(gal)	PT	Date	System Description: 25% Reduction		☐ Business	No. Persons	6	☐ Private
Pump Make	Model		Serial #	Repair System Description: 50% Reduction		☐ Other	No. Employees		☑ Public
# Nitrification Fields	1 # Lines 3		Linear Ft: 330	Maintenance Agreement Required:	☐ YES ☑ NO	☐ Slab	☑ Crawl Space		☐ Community
Trench Width	36" Max. Trench Bottom Depth 36"		Gravel Depth N/A	☑ GRAVITY	☐ PRESSURE	☐ Basement w/plumbing			☐ Basement w/o plumbing

Comments / Conditions: Improvements only. Submit floor plan prior to issuance of CA. Install a 25% Reduction system on contour with serial distribution. ~~&~~ Install trench bottoms @ 36" on high side ~~of Add~~

INITIAL SITE SKETCH

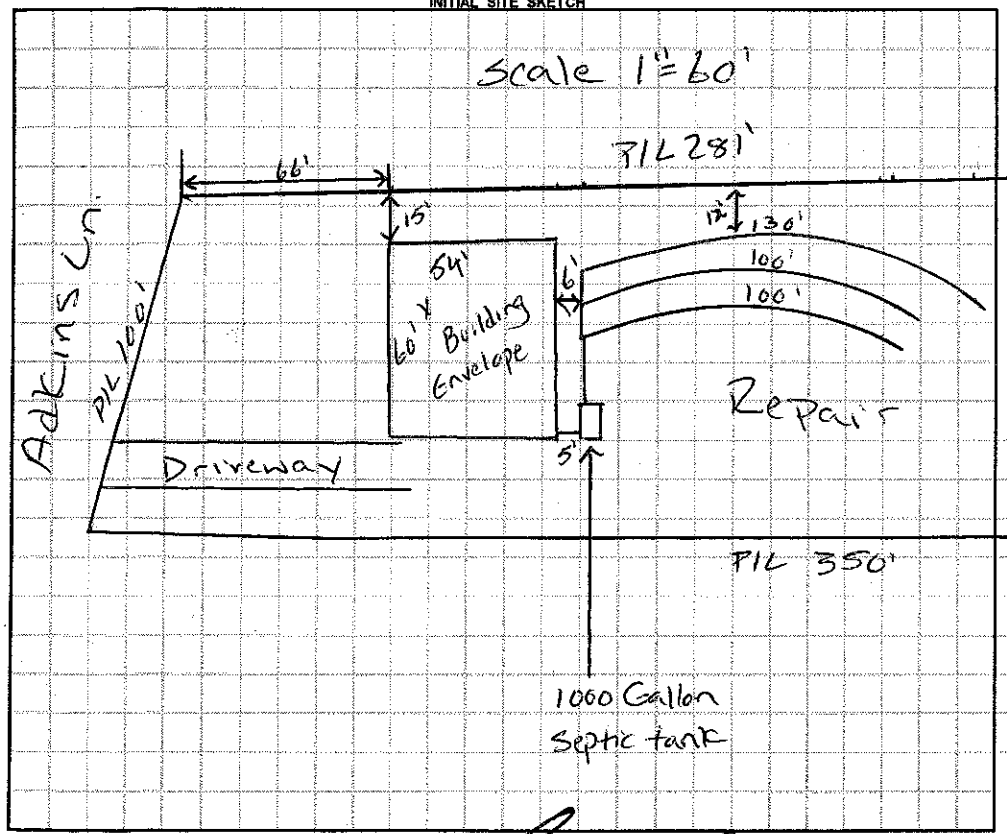

AS BUILT SKETCH

- Red Polylok Pilte installed
- Quick 4 chambers installed
- Installed as drawn
- House NOT set @ time of Installation

Permit can be suspended or revoked if any false information is supplied toward securing the permit / any unauthorized changes are made to the site / any unauthorized changes are made in the installation of the system. **CONTACT A LOCATOR SERVICE PRIOR TO ANY EXCAVATION**

☐ **IMPROVEMENT PERMIT** *with plat valid without expiration.* ☑ **IMPROVEMENT PERMIT** *with site plan valid for 60 mos.* ☐ **AUTHORIZATION TO CONSTRUCT** *valid for period equal to IMPROVEMENT PERMIT--not to exceed 60 mo.*

Owner / Applicant Signature: Date: 8-13-15 Installed By: Bryant Contracting

IMPROVEMENT PERMIT by: Justin Henderson Date: 8-13-15 OPERATION PERMIT by: Justin Henderson Date: 1-20-16

AUTHORIZATION TO CONSTRUCT by: Justin Henderson Date: 1/15/16 Existing System Inspected by: Date:

Health Dept. Copy - WHITE Applicant (Final Approval) - YELLOW Applicant (Conditional Approval) - PINK