IREDELL COUNTY HEALTH DEPARTMENT

Statesville Office (704) 878-5305 Mooresville Office (704) 660-3625 PERMIT # 211730

IMPROVEMENT PERMIT / AUTHORIZATION TO CONSTRUCT / OPERATION PERMIT / EXISTING SYSTEM

PIN # 4703575702 5032

APPLICANT: Troutman Family LDP APPLICANT ADDRESS: 232 Davie Ave

SITE ADDRESS: 128 Adkins Ln. PHONE: 704-873-5233 ALT. PHONE: N/A

SITE DIRECTIONS: Hwy 70 West TR Shady Rest TR Adkins Ln Property on Right


SUBDIVISION: Morrow Meadows SECTION: N/A LOT # 33434 LOT AREA: 1.91 acres DESIGN FLOW: 360gpd L.T.A.R.: 0.2

Septic Tank	1000 (gal)	STB	766-1000	Date	2-28	☑ New System ☐ Repair ☐ Expansion	System Type: I II (III) IV V VI	☑ Residence	No. Bedrooms 3
Pump Tank	(gal)	PT		Date		System Description:	10" Large Diameter Pipe w/Cover	☐ Business	No. Persons 6
Pump Make	Model			Serial #		Repair System Description:	DRIP	☐ Other	No. Employees
# Nitrification Fields	1	# Lines	7	Linear Ft:	720	Maintenance Agreement Required:	☐ YES ☑ NO	☐ Slab	☑ Crawl Space
Trench Width	36"	Max. Trench Bottom Depth	15" Highside	Gravel Depth	N/A		☑ GRAVITY ☐ PRESSURE	☐ Basement w/plumbing	☐ Basement w/o plumbing

Water Supply: ☐ Private ☑ Public ☐ Community

Comments / Conditions: IMPROVEMENTS ONLY! Combine + Record Lots Prior to issuance of CA + submit Floor plan. Install a Large Diamer Pipe system on Contour with Serial distribution utilizing Drop boxes. ✱ Backfill trenches, with soil classied as Group I, II or III, ✱✱ Soil Cap shall be Group III soil. ✱ Backfill + Soil Cap shall be approved by Heath Dept. on-site prior to installation ✱✱✱

INITIAL SITE SKETCH

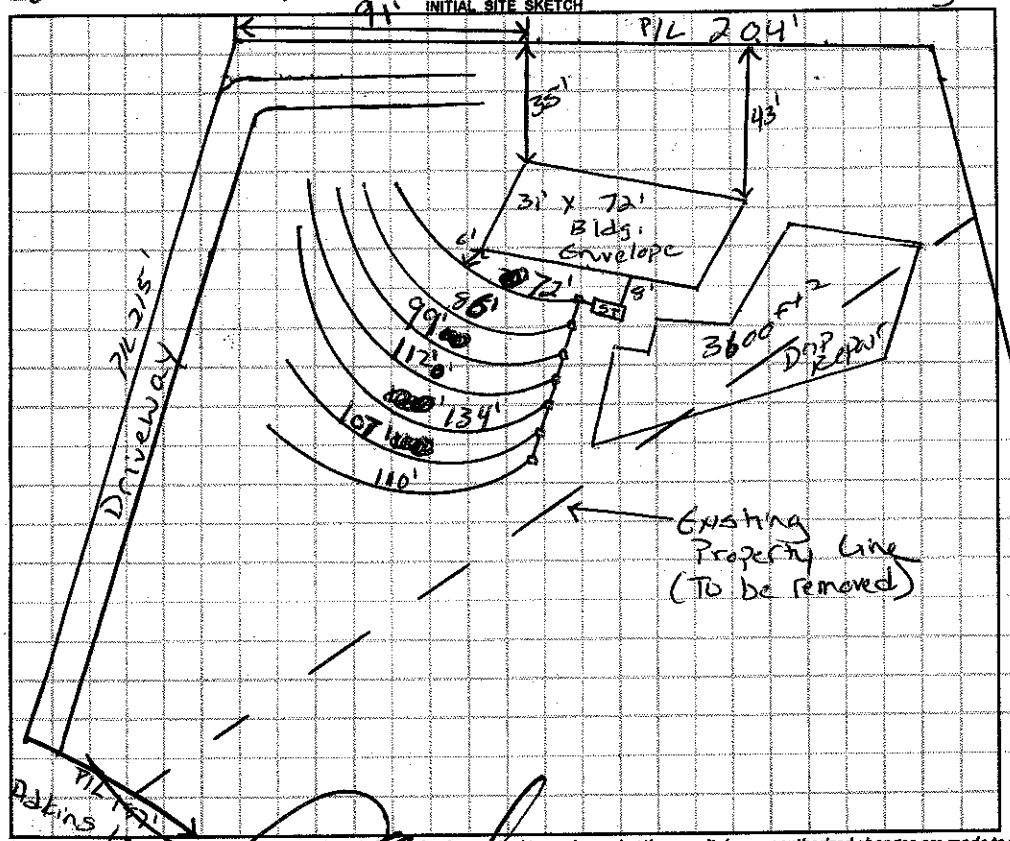

AS BUILT SKETCH

Scale 1" = 60'

- 10" LDT installed as drawn
- ~ 7"-10" Cover Placed uniformly over entire Nitrification field

06/15/16 Checked clear of foundation to supply line Truck packed to system Final Inspection

Permit can be suspended or revoked if any false information is supplied toward securing the permit / any unauthorized changes are made to the site / any unauthorized changes are made in the installation of the system. **CONTACT A LOCATOR SERVICE PRIOR TO ANY EXCAVATION**

☐ **IMPROVEMENT PERMIT** *with plat valid without expiration.* ☑ **IMPROVEMENT PERMIT** *with site plan valid for 60 mos.* ☑ **AUTHORIZATION TO CONSTRUCT** *valid for period equal to IMPROVEMENT PERMIT--not to exceed 60 mo.*

Owner / Applicant Signature: Date: 9-2-15 Installed by: Steve Bryant

IMPROVEMENT PERMIT by: Date: 8-25-15 OPERATION PERMIT by: Date: 06/15/16

AUTHORIZATION TO CONSTRUCT by: Date: 03/10/16 Existing System Inspected by: Date:

Health Dept. Copy - WHITE Applicant (Final Approval) - YELLOW Applicant (Conditional Approval) - PINK