IREDELL COUNTY HEALTH DEPARTMENT

STATESVILLE 704-878-5305 MOORESVILLE 704-664-5281

IMPROVEMENT PERMIT / CERTIFICATE OF COMPLETION / OPERATION PERMIT / EXISTING SYSTEM INSPECTION

PROPERTY DESCRIPTION NO. 25678 DATE 12-18-96 TAX MAP NO. 8m-B-106 Watershed: ☐ Yes ☑ No

OWNER OR CONTRACTOR James Munday PHONE: Business Home 872-2216

ADDRESS I-40 TL old mtn TL mocksmill TL Blackhawk 1/4 mi left

LOCATION 227 Stamey Fm Rd

SUBDIVISION Mundays mtn BLOCK / SECTION LOT 12 LOT AREA 120X140 SITE CLASS. 155 DESIGN FLOW 360 L.T.A.R. 133

Septic Tank: 1000 Gallons; STB 744 Date 12-16-96

Pump Tank: Gallons; PT Date

Pump Make: Model Serial No.

Nitrification Field: No Fields 1 Square Feet 1080 Linear Feet 360

No Lines 3 Trench Width 36" Max Trench Bottom Depth 36" Gravel Depth 12"

☑ New System ☐ Repair System Type: I (II) III, IV, V, VI

System Description: Conv. Gravity

Repair System Description: Pump To Chambers

Maintenance Agreement Required: ☐ Yes ☑ No

☐ House/Mod. Home No. Bedrooms 3

☑ Mobile Home No. Bathrooms 2

☐ Business No. Employees

☐ Other


☐ Slab ☑ Crawl Space ☐ Basement w/plumbing ☐ Basement wo/plumbing

Water Supply: ☐ Individual ☐ Community ☑ Public


Comments:

Comments:

INITIAL SITE SKETCH

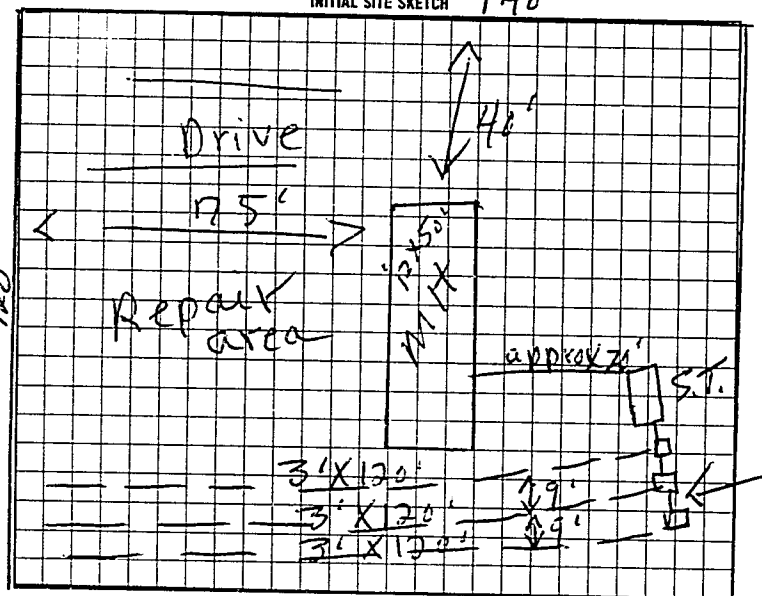

AS BUILT SKETCH

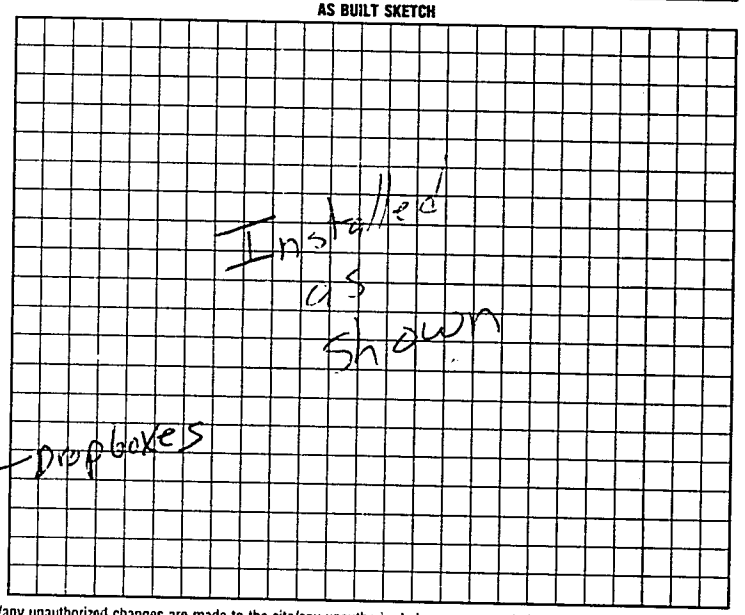

I understand that this permit can be suspended or revoked if any false information is supplied toward securing the permit/any unauthorized changes are made to the site/any unauthorized changes are made in the installation of the system. Improvement Permit is valid for 60 months from date of issuance.

Signed: X James Munday

Improvement Permit by: L.C. Moore date 12-18-96

Existing System Inspection by: L.C. Moore date 12-18-96

Installed by: James Hadler

Certificate of Completion by: date

Operation Permit by: Mont C Ont RS date 1-8-97

WHITE: HEALTH DEPT. COPY. INSPECTION COPY (FINAL): GREEN OWNER COPY (FINAL): YELLOW INSPECTION COPY (INITIAL): PINK OWNER COPY (INITIAL): GOLD

TO CCIII authorization to const. Expires 60 mos from issue

1291 00