IREDELL COUNTY HEALTH DEPARTMENT

STATESVILLE 704-878-5305 MOORESVILLE 704-664-5281

IMPROVEMENT PERMIT / AUTHORIZATION TO CONSTRUCT / OPERATION PERMIT / EXISTING SYSTEM INSPECTION

PERMIT# REPAIR PIN# 4703-59-5846.153 DATE 3-18-05

OWNER OR CONTRACTOR JAMES MUNDAY PHONE: Business 704-495-5111 Home 704-872-2216

ADDRESS 227 STAMEY FARM RD, STATESVILLE, NC 28677-8325

LOCATION I-40 W, TL OLD I MTN. RD, TR BELMONT CH. ROAD, TL BLACKHAWK DR, TO BLOCK HOUSE

SUBDIVISION _____ BLOCK / SECTION _____ LOT _____ LOT AREA 6.5 ACRES SITE CLASS. PS DESIGN FLOW 240' L.T.A.R. EXISTING

Septic Tank: EXISTING Gallons; STB _____ Date _____

Pump Tank: _____ Gallons; PT _____ Date _____

Pump Make: _____ Model _____ Serial No. _____

Nitrification Field: No Fields 1 Square Feet 225 Linear Feet 75

No Lines ONE Trench Width 36" Max Trench Bottom Depth 36 +/- Gravel Depth 24"

☐ New System ☑ Repair System Type: I, II, III, IV, V, VI

System Description: CONVENTIONAL, GRAVITY

Repair System Description: CONVENTIONAL, GRAVITY

Maintenance Agreement Required: ☐ Yes ☑ No

☑ House/Mod. Home No. Bedrooms 2

☐ Mobile Home No. Bathrooms 1

☐ Business No. Employees ____

☐ Other _____

☐ Slab ☑ Crawl Space ☐ Basement w/plumbing ☐ Basement wo/plumbing


Water Supply: ☐ Individual ☑ Public ☐ Community

Comments:/Conditions: INSTALL NEW DISTRIBUTION BOX AT LOCATION SHOWN FEEDING NEW 3' x 75' LINE USING 24" STONE.

Comments:/Conditions: NEW SANITARY TEE INSTALLED IN SEPTIC TANK-(

Site Address: 153 Blackhawk Dr. Stat 28677

INITIAL SITE SKETCH

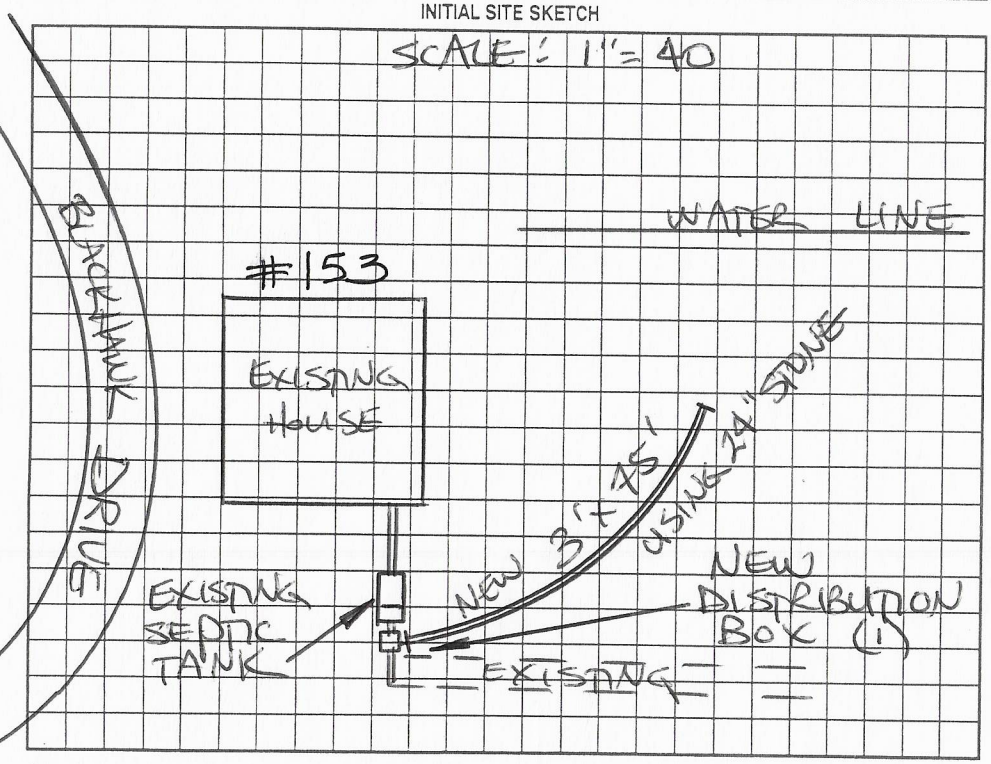

AS BUILT SKETCH

SYSTEM REPAIRED ACCORDING TO INITIAL SITE SKETCH

Permit can be suspended or revoked if any false information is supplied toward securing the permit/any unauthorized changes are made to the site/any unauthorized changes are made in the installation of the system. Improvement Permit with plat valid without expiration. Improvement Permit with site plan valid for sixty months. Authorization to Construct is valid for a period equal to that of Improvement Permit – not to exceed sixty months.

Signed: James Munday date 3-18-05 Installed by: JAMES HUBER

Improvement Permit by: STEVE HEDRICK date 3-18-05 Operation Permit by: STEVE HEDRICK date 3-21-05

Authorization to Construct by: STEVE HEDRICK date 3-18-05 Existing System Inspection by: _____ date _____

HEALTH DEPT. COPY: WHITE OWNER COPY (FINAL): YELLOW OWNER COPY (INITIAL): PINK