IREDELL COUNTY HEALTH DEPARTMENT

Statesville Office (704) 878-5305 Mooresville Office (704) 660-3625 PERMIT # 207645

IMPROVEMENT PERMIT / AUTHORIZATION TO CONSTRUCT / OPERATION PERMIT / EXISTING SYSTEM

PIN # 4703619358

APPLICANT: Newton Drive LLC APPLICANT ADDRESS: P.O. Box 1370 Cornelius NC 28031

SITE ADDRESS: 328 Morrow Farm Rd Statesville NC PHONE: 704-576-8001 ALT. PHONE: N/A

SITE DIRECTIONS: 40 to Old Mtn T/L then T/R Lewis Ferry Rd T/R Morrow Farm Rd T/L Gravel Drive

SUBDIVISION: N/A SECTION: N/A LOT # N/A LOT AREA: 15 ac DESIGN FLOW: 240 L.T.A.R.: Ey

Septic Tank Ey (gal) STB Date

Pump Tank (gal) PT Date

Pump Make Model Serial #

Nitrification Fields Ey # Lines Ey Linear Ft: Ey

Trench Width Ey Max. Trench Bottom Depth Ey Gravel Depth Ey

☐ New System ☐ Repair ☐ Expansion System Type: I ☒ II III IV V VI

System Description: Existing

Repair System Description:

Maintenance Agreement Required: ☐ YES ☒ NO

☒ GRAVITY ☐ PRESSURE

☒ Residence No. Bedrooms 2

☐ Business No. Persons 4

☐ Other No. Employees

☒ Slab ☐ Crawl Space

☐ Basement w/plumbing ☐ Basement w/o plumbing

Water Supply


☒ Private

☐ Public


☐ Community

Comments / Conditions: All building foundations must be 35' from any part of SFS and 25' from any well

INITIAL SITE SKETCH

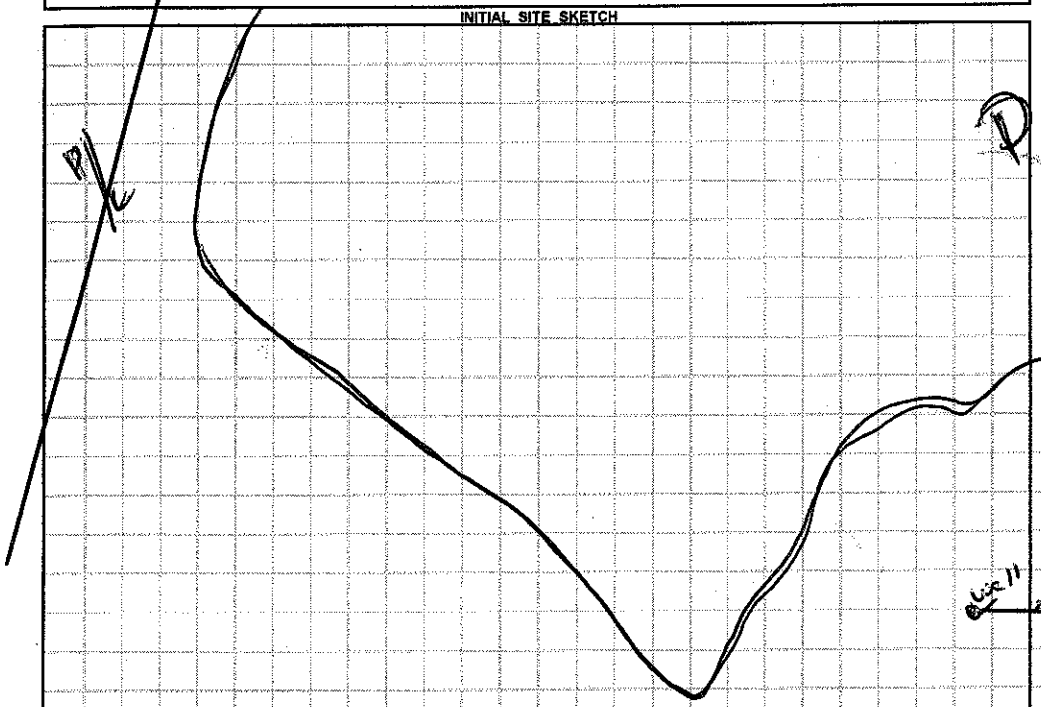

AS BUILT SKETCH

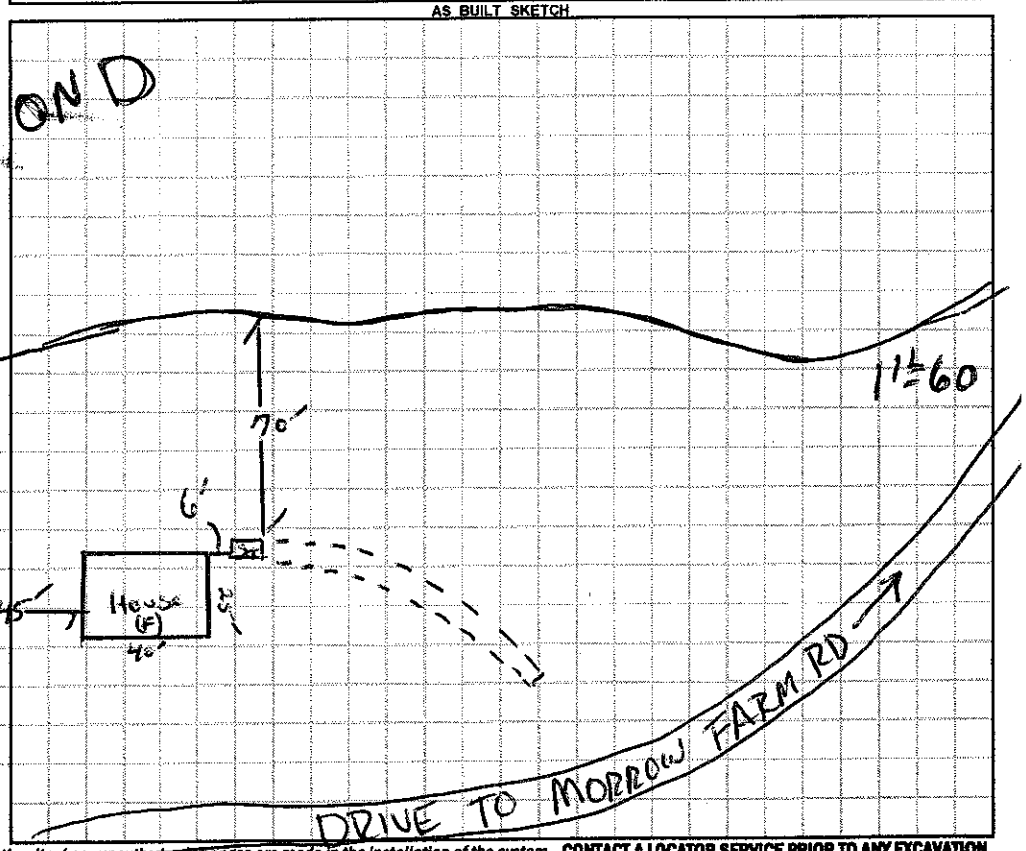

Permit can be suspended or revoked if any false information is supplied toward securing the permit / any unauthorized changes are made to the site / any unauthorized changes are made in the installation of the system. **CONTACT A LOCATOR SERVICE PRIOR TO ANY EXCAVATION**

☐ **IMPROVEMENT PERMIT** *with plat valid without expiration.* ☐ **IMPROVEMENT PERMIT** *with site plan valid for 60 mos.* ☐ **AUTHORIZATION TO CONSTRUCT** *valid for period equal to IMPROVEMENT PERMIT--not to exceed 60 mo.*

Owner / Applicant Signature: Date: 7.7.15 Installed by:

IMPROVEMENT PERMIT by: Date: OPERATION PERMIT by: Date:

AUTHORIZATION TO CONSTRUCT by: Date: Existing System Inspected by: Date: 07/01/15

Health Dept. Copy - WHITE Applicant (Final Approval) - YELLOW Applicant (Conditional Approval) - PINK