IREDELL COUNTY HEALTH DEPARTMENT

STATESVILLE 704-878-5305 MOORESVILLE 704-664-5281

IMPROVEMENT PERMIT / AUTHORIZATION TO CONSTRUCT / OPERATION PERMIT / EXISTING SYSTEM INSPECTION

PERMIT# 110154 PIN# ~~4703-62-7939.B~~ 4703-62-7839 DATE 12-10-02

OWNER OR CONTRACTOR LUV HOMES PHONE: Business 704-829-2990 Home

ADDRESS 241 SUZANNE LANE, STATESVILLE NC 28677

LOCATION US 70 WEST TL SHADY REST ROAD, TR SUZANNE LANE, BEHIND LAST MH ON LEFT

SUBDIVISION SHADY REST BLOCK / SECTION LOT 4 LOT AREA 2.671 ACRES (TOTAL) SITE CLASS. PS DESIGN FLOW 360 L.T.A.R. 0.35 GPD/FT²

Septic Tank: 1000 Gallons; STB 794 Date 12/07/02
Pump Tank: Gallons; PT Date
Pump Make: Model Serial No.
Nitrification Field: No Fields 1 Square Feet 1035 Linear Feet 345
No Lines THREE Trench Width 36" Max Trench Bottom Depth 36" Gravel Depth 12"

☑ New System ☐ Repair System Type: I (II), III, IV, V, VI
System Description: CONVENTIONAL, GRAVITY
Repair System Description: 50% REDUCTION, pump
Maintenance Agreement Required: ☐ Yes ☑ No


☐ House/Mod. Home ☑ Mobile Home ☐ Business ☐ Other
No. Bedrooms 3 No. Bathrooms 2 No. Employees
☐ Slab ☑ Crawl Space ☐ Basement w/plumbing ☐ Basement wo/plumbing

Water Supply: ☑ Individual ☐ Public ☐ Community
WELL NEXT DOOR

Comments/Conditions: INSTALL SUBSURFACE INTERCEPT DRAINAGE DITCH AT LOCATION SHOWN BEGINNING 48" DEEP OUT TO DAYLIGHT

Comments/Conditions: -SEPTIC TANK INSTALLED USING TANK MARKER & ZABEL FILTER,
* SYSTEM INSTALLED DURING PERIOD OF MOIST SOIL CONDITIONS,

INITIAL SITE SKETCH

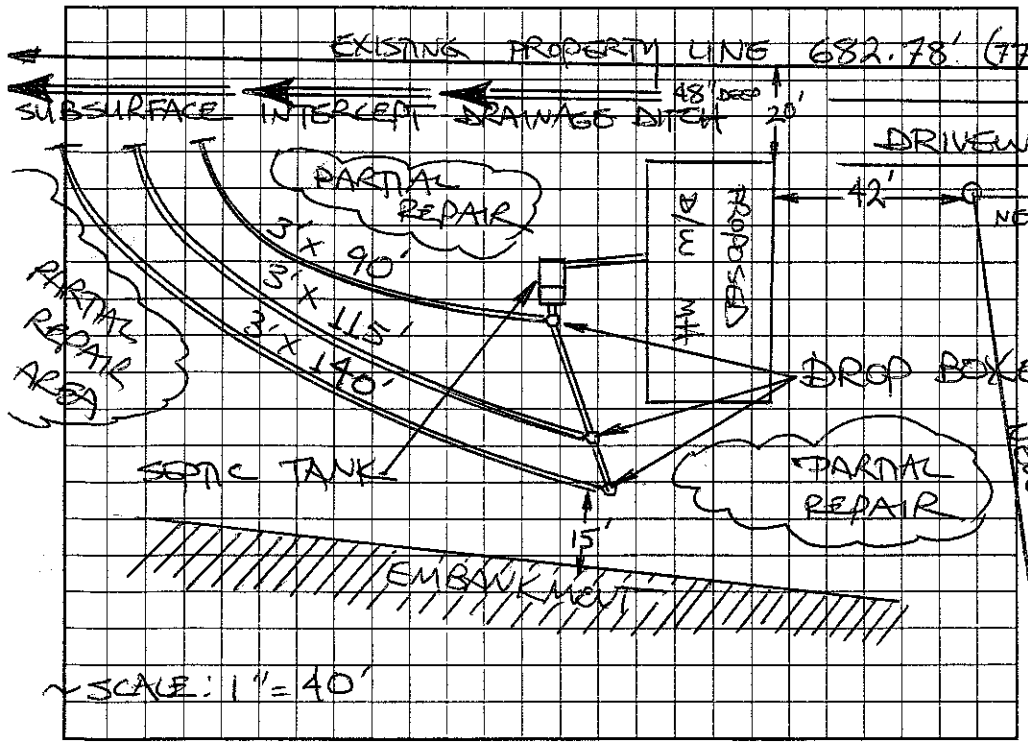

AS BUILT SKETCH

* SYSTEM INSTALLED AS SHOWN IN INITIAL SITE SKETCH

Permit can be suspended or revoked if any false information is supplied toward securing the permit/any unauthorized changes are made to the site/any unauthorized changes are made in the installation of the system. Improvement Permit with plat valid without expiration. Improvement Permit with site plan valid for sixty months. Authorization to Construct is valid for a period equal to that of Improvement Permit – not to exceed sixty months.

Signed: [signature] date 12-10-2002 Installed by: TODD UPRIGHT 01-21-03

Improvement Permit by: STEVE HENDRICK date 12-10-02 Operation Permit by: Patrick Mitchell date 01/22/03

Authorization to Construct by: STEVE HENDRICK date 12-10-02 Existing System Inspection by: date

HEALTH DEPT. COPY: WHITE OWNER COPY (FINAL): YELLOW OWNER COPY (INITIAL): PINK