IREDELL COUNTY HEALTH DEPARTMENT

Statesville Office (704) 878-5305 Mooresville Office (704) 660-3625

IMPROVEMENT PERMIT / AUTHORIZATION TO CONSTRUCT / OPERATION PERMIT / EXISTING SYSTEM

PERMIT # 205264

APPLICANT: Elliot Odom APPLICANT ADDRESS: 256 Lakeshore dr Mooresville NC 28677

SITE ADDRESS: 117 Bobby's Loop Statesville NC 28677 PHONE: 704-724-9909 ALT. PHONE: N/A

SITE DIRECTIONS: 70 1 mile West of old mtn Rd MHP on left


SUBDIVISION: Hickory Ridge Mobile Home Park SECTION: N/A LOT # 11 LOT AREA: 4.3ac DESIGN FLOW: 240 L.T.A.R.: EX

Septic Tank	EX (gal)	STB	Date	☐ New System ☐ Repair ☐ Expansion System Type: I ☒ II III IV V VI	☒ Residence	No. Bedrooms	2	Water Supply	
Pump Tank	(gal)	PT	Date	System Description: Existing	☐ Business	No. Persons	4	☐ Private	
Pump Make	Model		Serial #	Repair System Description:	☐ Other	No. Employees		☒ Public	
# Nitrification Fields	EX # Lines	EX	Linear Ft: EX	Maintenance Agreement Required: ☐ YES ☒ NO	☐ Slab	☒ Crawl Space		☐ Community	
Trench Width	EX Max. Trench Bottom Depth	EX	Gravel Depth EX	☒ GRAVITY ☐ PRESSURE	☐ Basement w/plumbing			☐ Basement w/o plumbing	

Comments / Conditions: All building foundations must be 5' from any part of STS.

INITIAL SITE SKETCH

AS BUILT SKETCH

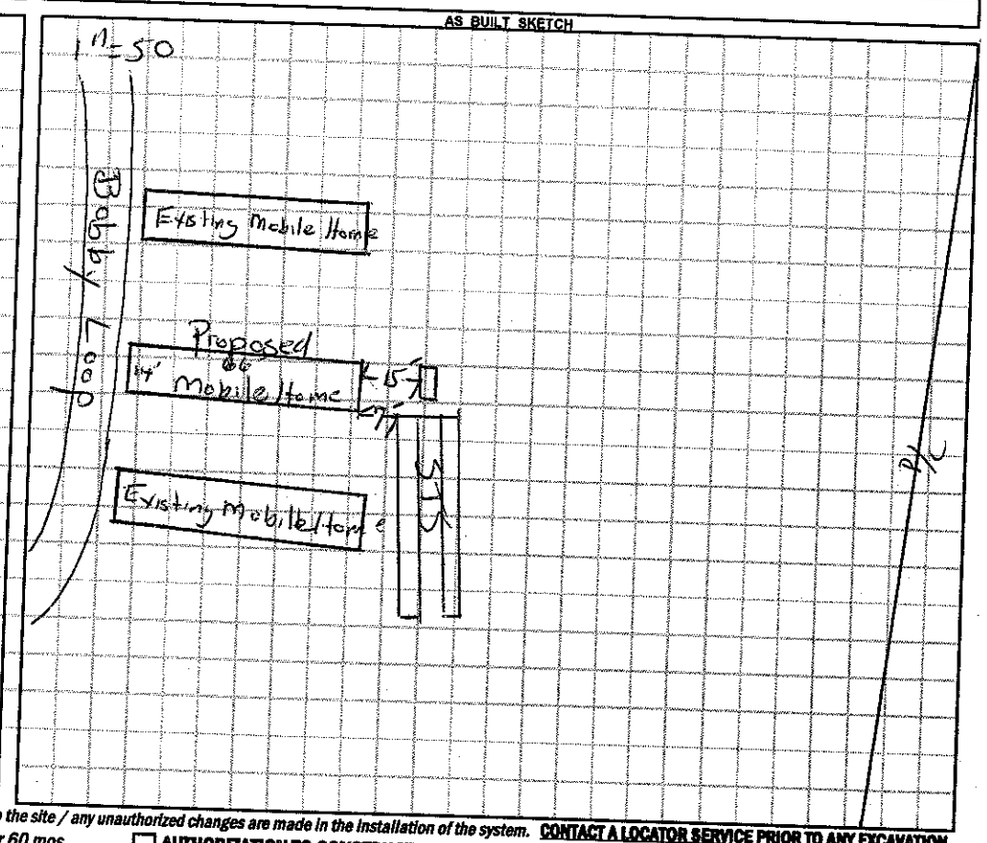

Permit can be suspended or revoked if any false information is supplied toward securing the permit / any unauthorized changes are made to the site / any unauthorized changes are made in the installation of the system. **CONTACT A LOCATOR SERVICE PRIOR TO ANY EXCAVATION**

☐ **IMPROVEMENT PERMIT** *with plat valid without expiration.* ☐ **IMPROVEMENT PERMIT** *with site plan valid for 60 mos.* ☐ **AUTHORIZATION TO CONSTRUCT** *valid for period equal to IMPROVEMENT PERMIT--not to exceed 60 mo.*

Owner / Applicant Signature: _____ Date: _____ Installed by: _____

IMPROVEMENT PERMIT by: _____ Date: _____ OPERATION PERMIT by: _____ Date: _____

AUTHORIZATION TO CONSTRUCT by: _____ Date: _____ Existing System Inspected by: _____ Date: 08/18/14

Health Dept. Copy - WHITE Applicant (Final Approval) - YELLOW Applicant (Conditional Approval) - PINK