IREDELL COUNTY HEALTH DEPARTMENT - *ENVIRONMENTAL HEALTH* ☑ STATESVILLE OFFICE 704-878-5305 ☐ MOORESVILLE OFFICE 704-664-5281

IMPROVEMENT PERMIT / AUTHORIZATION TO CONSTRUCT / OPERATION PERMIT / EXISTING SYSTEM INSPECTION

PERMIT # 170180 PIN # 4703-65-9921 DATE JANUARY 18, 2012

OWNER SYNERGY ASSET GROUP APPLICANT: PHONE: Home/Cell # 704-878-2550 Business #

SITE ADDRESS 104 Bobby's Loop STATESVILLE OWNER / APPLICANT ADDRESS

SITE DIRECTIONS US 70 WEST, MHP ON LEFT AT SHADY REST ROAD, TL BOBBY'S LOOP TO END

SUBDIVISION HICKORY RIDGE BLOCK / SECTION LOT # 5 LOT AREA 4.3 ACRES DESIGN FLOW 240 L.T.A.R. EX

Septic Tank 1500 Gallons: STB Date

Pump Tank Gallons: P T Date

Pump Make Model Serial #

No. Nitrification Fields: 1 No. Lines 1 BSA Linear Feet 10' X 120'

Trench Width 10' X 120' Max. Trench Bottom Depth — Gravel Depth 16"

☐ New System ☐ Repair ☐ Expansion System Type I II III IV V VI

System Description: CONVENTIONAL GRAVITY

Repair System Description:

Maintenance Agreement Required ☐ YES ☑ NO

☑ GRAVITY ☐ PRESSURE

☑ Residence No. Bedrooms 2

☐ Business No. Persons

☐ Other No. Employees

☐ Slab ☐ Crawl Space

☐ Basement w/plumbing ☐ Basement w/o plumbing

Water Supply

☐ Private

☑ Public


☐ Community

Comments / Conditions


KEEP MH MINIMUM 5' FROM SYSTEM.

APPROVED FOR TWO 2-BEDROOM MH'S

INITIAL SITE SKETCH

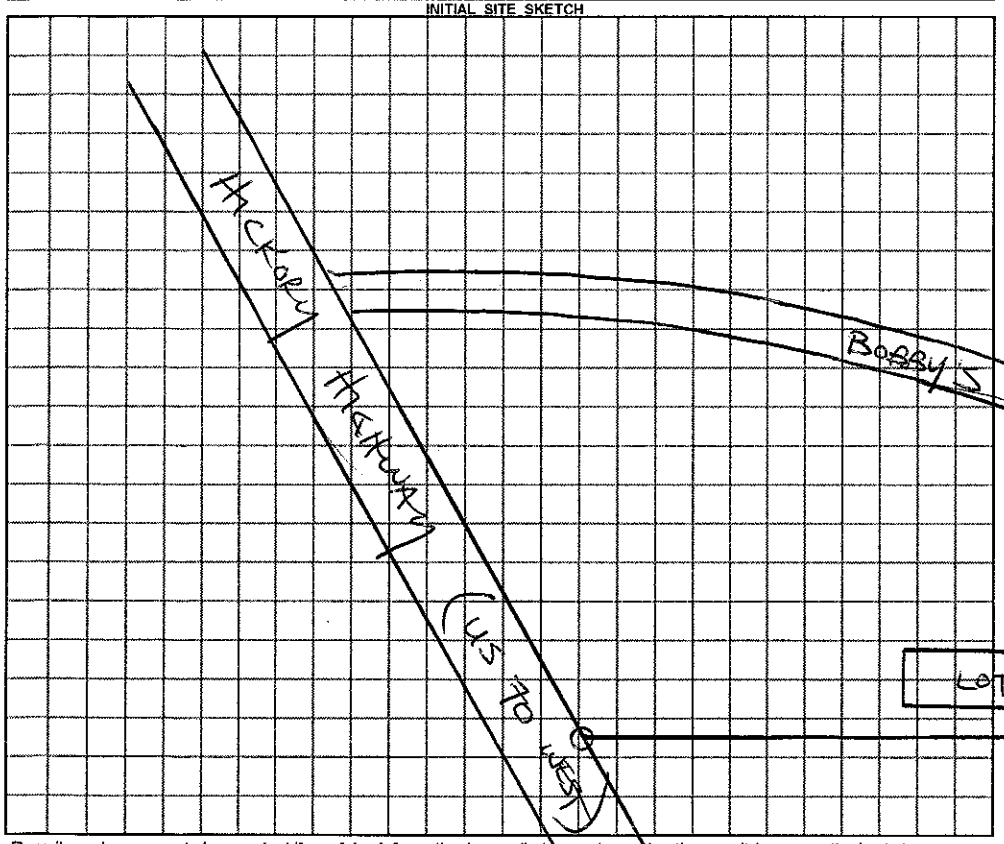

AS BUILT SKETCH

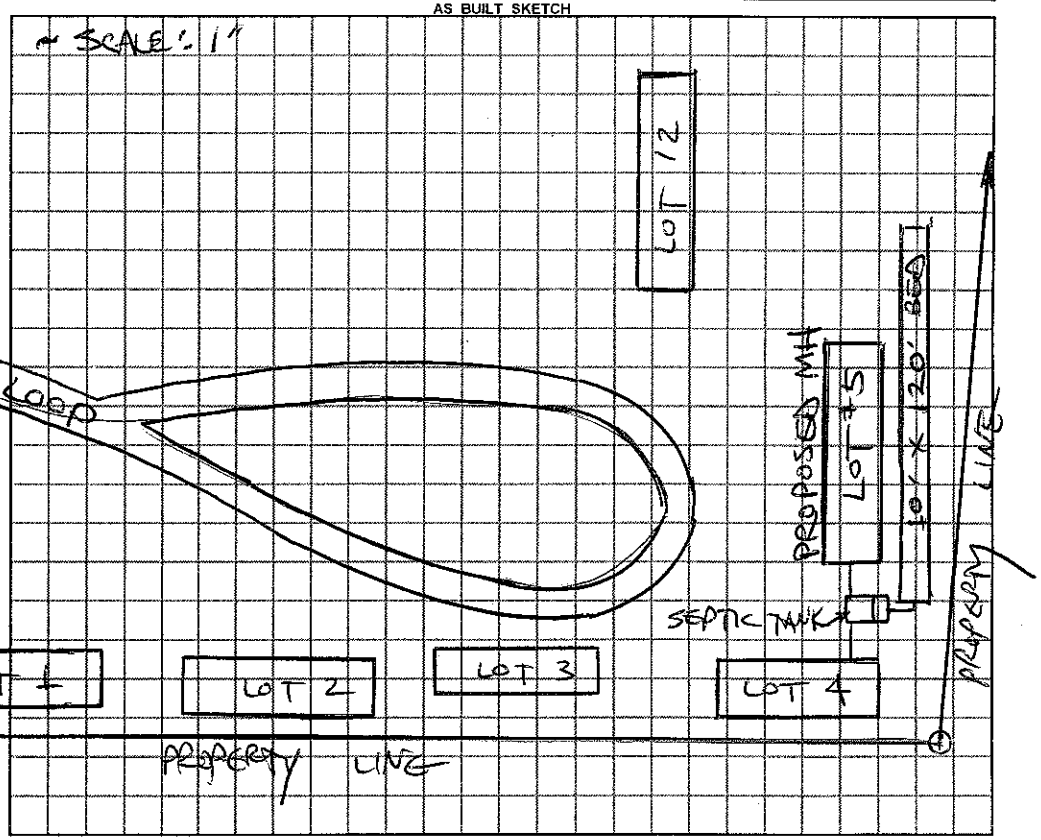

Permit can be suspended or revoked if any false information is supplied toward securing the permit / any unauthorized changes are made to the site / any unauthorized changes are made in the installation of the system.

☐ ***IMPROVEMENT PERMIT*** with plat valid without expiration. ☐ ***IMPROVEMENT PERMIT*** with plat valid without expiration. site plan valid 60 mo. ☐ ***AUTHORIZATION TO CONSTRUCT*** valid for period equal to IMPROVEMENT PERMIT--not to exceed 60 mo.

Owner / Applicant Signature: [signature] Date 2/10/12 Installed by:

IMPROVEMENT PERMIT by: REHS Date OPERATION PERMIT by: REHS Date

AUTHORIZATION TO CONSTRUCT by: REHS Date Existing System Inspected by: STEVE HEDRICK REHS Date 1-18-12

YOU SHOULD CONTACT A LOCATOR SERVICE PRIOR TO ANY EXCAVATION

White Copy -- Environmental Health YELLOW COPY (Final) Owner / Applicant PINK COPY (initial) Owner / Applicant