IREDELL COUNTY HEALTH DEPARTMENT

Statesville Phone TR 3-7271 — Mooresville Phone NO 3-1271

PERMIT TO INSTALL SEPTIC TANK

Permit NO. _____ Permit Date Nov 11 1959

Owner Parlier Plbg. Boat-got Address near white oak

Installed By CLYDE HOKE Address _____


Location of Property left at white oak - Right on 1st Paved Rd. new brick before church on Right

Tank		Capacity		Length of Lines		Fixtures	
Block	( )	800	( )	150'	(✓)	No. of Baths	( )
Precast	(✓)	900	(✓)	175'	( )	Dishwasher	( )
		1000	( )	200'	( )	Garbage Grdr.	( )
		1100	( )	225'	( )	Auto-Washer	( )
		1200	( )	250'	( )	Other _____	
		Other _____		Other _____			

NOTIFY HEALTH DEPARTMENT AT LEAST EIGHT HOURS BEFORE TANK IS TO BE INSPECTED.

Final Inspection Nov 11 1959 Approved ( ) Disapproved ( )

Remarks Not for Washer well 100ft. dep app

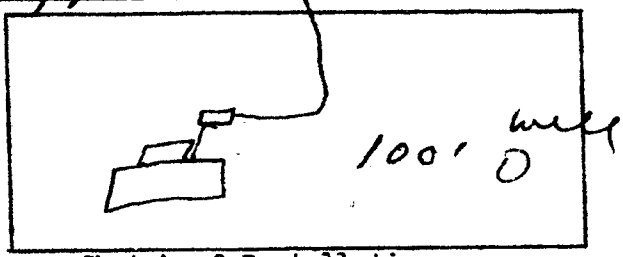

Sketch of Installation

R.L.

Sanitarian