pd. 3/25 CD

IREDELL COUNTY HEALTH DEPARTMENT

STATESVILLE 704-878-5305 MOORESVILLE 704-664-5281

IMPROVEMENT PERMIT / AUTHORIZATION TO CONSTRUCT / OPERATION PERMIT / EXISTING SYSTEM INSPECTION

PERMIT# 094545 PIN# 4703 [redacted] 7406 96 DATE 2/28/01

OWNER OR CONTRACTOR Charles Goodman PHONE: Business _____ Home (704) 528-7888

ADDRESS 172 Suzanne Lane Statesville, NC 28677

LOCATION 70W @ Shady Rest, @ Suzanne Lane, 10th on Right, behind Lot 3A (Brown Mobile Home).

SUBDIVISION Shady Rest MHP BLOCK / SECTION II LOT 3 LOT AREA .71 Acres SITE CLASS V DESIGN FLOW 360 L.T.A.R. .3

Septic Tank: 4,000 Gallons: STB 1012 Date 9-30-00

Pump Tank: _____ Gallons: PT _____ Date _____

Pump Make: _____ Model _____ Serial No. _____

Nitrification Field: No Fields 1 Square Feet 1200 Linear Feet 400

No Lines 2 Trench Width 36" Max Trench Bottom Depth 30" Gravel Depth 12"

[X] New System [ ] Repair System Type: [ ] I [X] II [ ] III [ ] IV [ ] V [ ] VI

System Description: Gravity, Conventional

Repair System Description: Pump, 50% Reduction

Maintenance Agreement Required: [ ] Yes [X] No

[ ] House/Mod. Home [X] Mobile Home [ ] Business [ ] Other

No. Bedrooms 3 No. Bathrooms 2 No. Employees _____


Water Supply: [X] Individual [ ] Public [ ] Community

[ ] Slab [X] Crawl Space [ ] Basement w/plumbing [ ] Basement wo/plumbing

Comments/Conditions: ① Do not install when wet ② Install lines on contour ③ Keep lines 10ft from property line ④ Keep lines @ min. 60ft from well

Comments/Conditions: - Poly lock fitter installed
- Tank risers installed
- Installed flow divider tee, per Health Dept request instead of distribution box

INITIAL SITE SKETCH

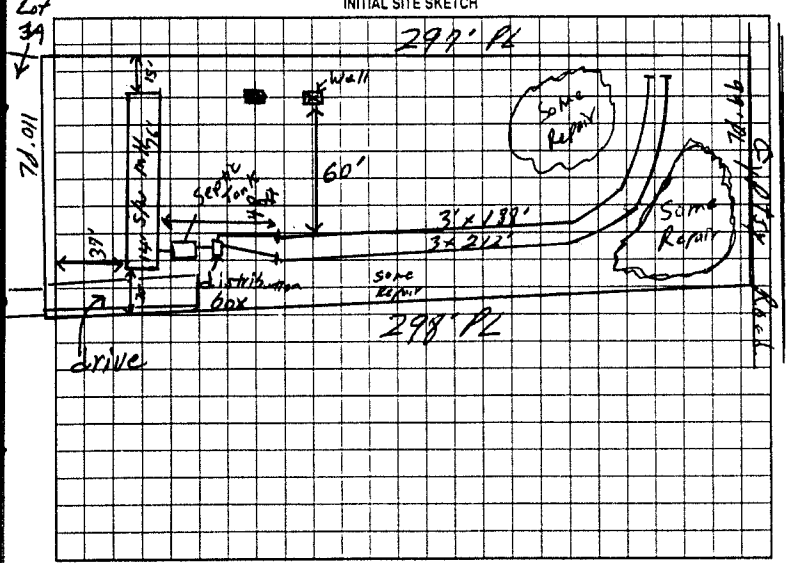

AS BUILT SKETCH

Installed as per Initial Site Sketch

Permit can be suspended or revoked if any false information is supplied toward securing the permit/any unauthorized changes are made to the site/any unauthorized changes are made in the installation of the system. Improvement Permit with plat valid without expiration. Improvement Permit with site plan valid for sixty months. Authorization to Construct is valid for a period equal to that of Improvement Permit – not to exceed sixty months.

Signed: Charles Goodman date _____

Improvement Permit by: William O. Johnson RSI date 2/28/01

Authorization to Construct by: William O. Johnson RSI date 2/28/01

Installed by: Statesville Backhoe

Operation Permit by: William O. Johnson RSI date 4/5/01

Existing System Inspection by: _____ date _____

HEALTH DEPT COPY WHITE OWNER COPY (FINAL) YELLOW OWNER COPY (INITIAL) PINK