IREDELL COUNTY HEALTH DEPARTMENT

STATESVILLE 704-878-5305 (C) MOORESVILLE 704-664-5281

IMPROVEMENT PERMIT / AUTHORIZATION TO CONSTRUCT / OPERATION PERMIT / EXISTING SYSTEM INSPECTION

PERMIT# 137047 PIN# 4703-74-5785 95 DATE 7-29-06

OWNER OR APPLICANT FREEDOM HOMES - STATESVILLE #669 PHONE: Business 704-872-0179 Home

ADDRESS 1270 NORTHSIDE DRIVE, STATESVILLE NC 28677

LOCATION US 70 WEST, TL SHADY REST ROAD, TR SUZANNE LANE 0.2 MILE ON LEFT

SUBDIVISION HAWKS BLOCK / SECTION LOT 12 LOT AREA 0.706 ACRE SITE CLASS. PS DESIGN FLOW 480 L.T.A.R. 0.30 GPD/FT²

Septic Tank: 1000 Gallons; STB 760 Date 4-2-06
Pump Tank: Gallons; PT Date
Pump Make: Model Serial No.
Nitrification Field: No Fields 1 Square Feet EQ.P 1920 Linear Feet 400
No Lines SIX Trench Width 36" Max Trench Bottom Depth 30"

☑ New System ☐ Repair ☐ Expansion System Type: I II III IV V VI
System Description: 25% REDUCTION, GRAVITY
Repair System Description: 25% REDUCTION, GRAVITY
Maintenance Agreement Required: ☐ Yes ☑ No
Gravel Depth N/A ☑ Gravity ☐ Pressure

☑ House/Mod. Home No. Bedrooms 4
☐ Mobile Home No. Persons
☐ Business No. Employees
☐ Other


Water Supply: ☑ Individual ☐ Public ☐ Community WELL

☐ Slab ☑ Crawl Space ☐ Basement w/plumbing ☐ Basement wo/plumbing


Comments/Conditions: ① GRADE DRAINFIELD AREA TO UNIFORM SLOPE PRIOR TO ISSUANCE OF AUTHORIZATION TO CONSTRUCT. ② OBTAIN ZONING CLEARANCE FOR 76' WIDE HOME. ③ INSTALL 25% REDUCTION SYSTEM ON CONTOUR. NO DEEPER THAN 30".

Comments/Conditions: SEPTIC TANK WITH MARKER INSTALLED USING "RED POLYLOK" FILTER

INITIAL SITE SKETCH

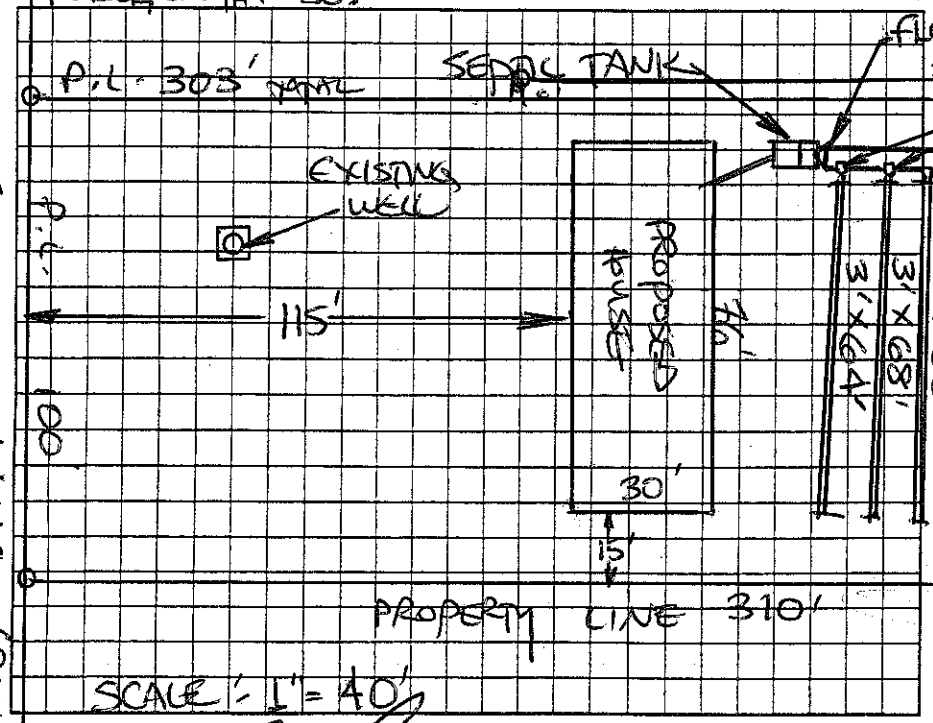

AS BUILT SKETCH

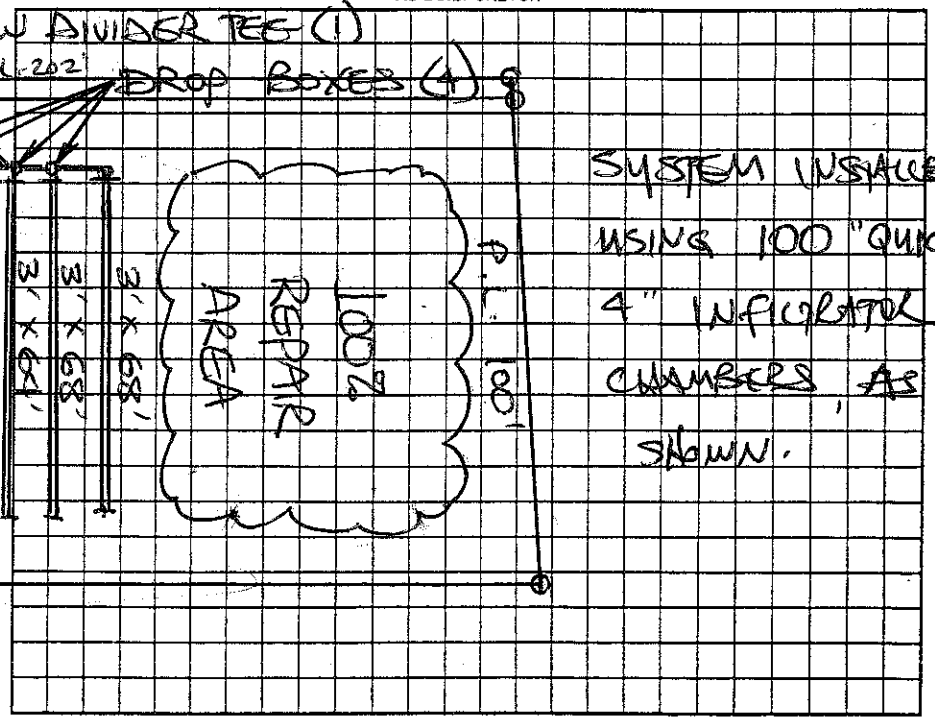

SUZANNE LANE (PAVED)

Permit can be suspended or revoked if any false information is supplied toward securing the permit/any unauthorized changes are made to the site/any unauthorized changes are made in the installation of the system. Improvement Permit with plat valid without expiration ☐ Improvement Permit with site plan valid for sixty months ☑ Authorization to Construct is valid for a period equal to that of Improvement Permit – not to exceed sixty months.

Signed: date 7-31-06 Installed by: ABEE'S GRADING

Improvement Permit by: STEVE HEDRICK date 7-29-06 Operation Permit by: STEVE HEDRICK date 8-15-06

Authorization to Construct by: STEVE HEDRICK date 8-7-06 Existing System Inspection by: date

HEALTH DEPT. COPY: WHITE OWNER COPY (FINAL): YELLOW OWNER COPY (INITIAL): PINK