IREDELL COUNTY HEALTH DEPARTMENT

STATESVILLE 704-878-5305 MOORESVILLE 704-664-5281

IMPROVEMENT PERMIT / AUTHORIZATION TO CONSTRUCT / OPERATION PERMIT / EXISTING SYSTEM INSPECTION

PERMIT# 090510 PIN# 4703-74-6905 DATE 7/21/00

OWNER OR CONTRACTOR Jason Boyt (Shirley Boyt) PHONE: Business Home 704-876-3857

ADDRESS 117 Dishman Lane Statesville, NC. 28625

LOCATION Off Mtn Rd. TR 70 L Shady Rest (R) Suzanne Ln. to 10th lot on (L)

SUBDIVISION HAWKS (ANSON) BLOCK / SECTION LOT 10 LOT AREA .64 SITE CLASS. P5 DESIGN FLOW 360 L.T.A.R. .35

Septic Tank: 1000 Gallons; STB 794 Date 6-20-00
Pump Tank: Gallons; PT Date
Pump Make: Model Serial No.
Nitrification Field: No Fields 1 Square Feet 1028 Linear Feet 342
No Lines 5@68' Trench Width 3' Max Trench Bottom Depth 36" Gravel Depth 12"

[X] New System [ ] Repair System Type: I (II) III, IV, V, VI
System Description: GRAV - CONVENTIONAL
Repair System Description: SAME
Maintenance Agreement Required: [ ] Yes [X] No
[ ] Slab [X] Crawl Space [ ] Basement w/plumbing [ ] Basement wo/plumbing


[ ] House/Mod. Home No. Bedrooms 3
[X] Mobile Home No. Bathrooms 2
[ ] Business No. Employees
[ ] Other

Water Supply: [X] Individual [ ] Public [ ] Community
LOT ON (R)


Comments:/Conditions:

Comments:/Conditions: Installed as shown

INITIAL SITE SKETCH (1" = 40')

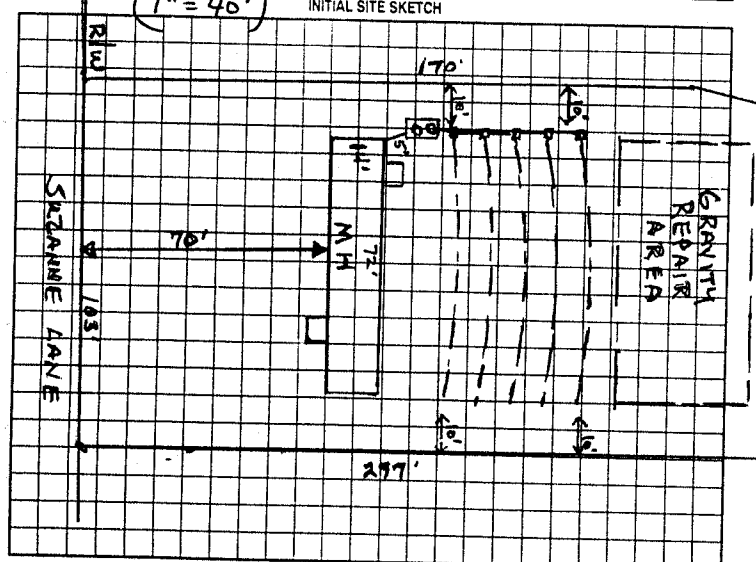

AS BUILT SKETCH

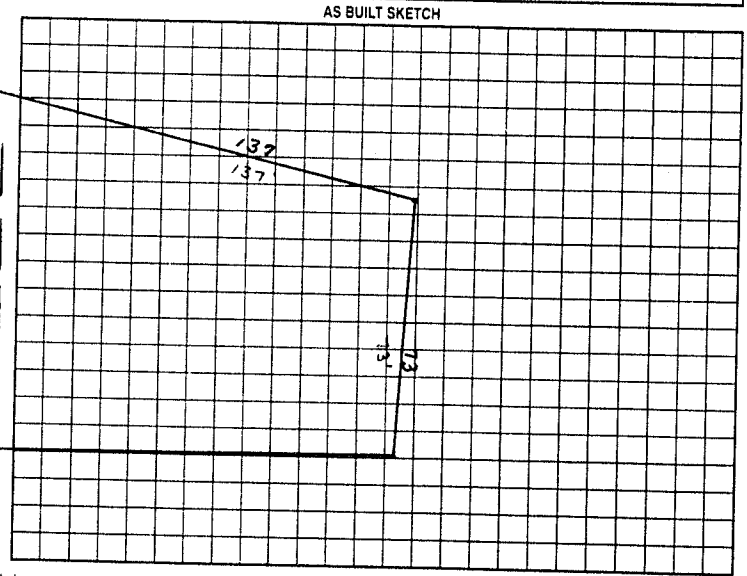

Permit can be suspended or revoked if any false information is supplied toward securing the permit/any unauthorized changes are made to the site/any unauthorized changes are made in the installation of the system. Improvement Permit with plat valid without expiration. Improvement Permit with site plan valid for sixty months. Authorization to Construct is valid for a period equal to that of Improvement Permit – not to exceed sixty months.

Signed: X date 7-24-00

Improvement Permit by: Wesley Sparks RS. date 7/21/00

Authorization to Construct by: Wesley Sparks RS. date 7/21/00

Installed by: Andy Daniels

Operation Permit by: [signature] RS date 8-2-00

Existing System Inspection by: date

HEALTH DEPT. COPY: WHITE OWNER COPY (FINAL): YELLOW OWNER COPY (INITIAL): PINK