IREDELL COUNTY HEALTH DEPARTMENT

STATESVILLE 704-878-5305 MOORESVILLE 704-664-5281

IMPROVEMENT PERMIT / AUTHORIZATION TO CONSTRUCT / OPERATION PERMIT / EXISTING SYSTEM INSPECTION

PERMIT# 136693 PIN# ~~4703753185~~ 4703753185 DATE 7-7-06

OWNER OR APPLICANT Sam + Cathy Parks PHONE: Business _____ Home 828-465-6854

ADDRESS 142 Susan Lane Statesville NC

LOCATION ~~70~~ W on Shady Rest Rd Swamp Ln Lot #6 on Right

SUBDIVISION Shady Rest BLOCK / SECTION _____ LOT 108 LOT AREA 1.450 SITE CLASS. PS DESIGN FLOW 360 L.T.A.R. 35

Septic Tank: 1000 Gallons: STB 1012 Date 3-7-96
Pump Tank: _____ Gallons: PT _____ Date _____
Pump Make: _____ Model _____ Serial No. _____
Nitrification Field: No Fields ___ Square Feet 1080 Linear Feet 360
No Lines 4 Trench Width 36 Max Trench Bottom Depth 12 Gravel Depth 12

☐ New System ☐ Repair ☐ Expansion System Type: I II III IV V VI
System Description: Existing
Repair System Description: _____
Maintenance Agreement Required: ☐ Yes ☐ No

☐ House/Mod. Home No. Bedrooms 3
☐ Mobile Home No. Persons ___
☐ Business No. Employees ___
☐ Other _____


Water Supply: ☐ Individual ☑ Public ☐ Community

☑ Gravity ☐ Pressure ☐ Slab ☐ Crawl Space ☐ Basement w/plumbing ☐ Basement wo/plumbing


Comments:/Conditions:

Comments:/Conditions:

INITIAL SITE SKETCH

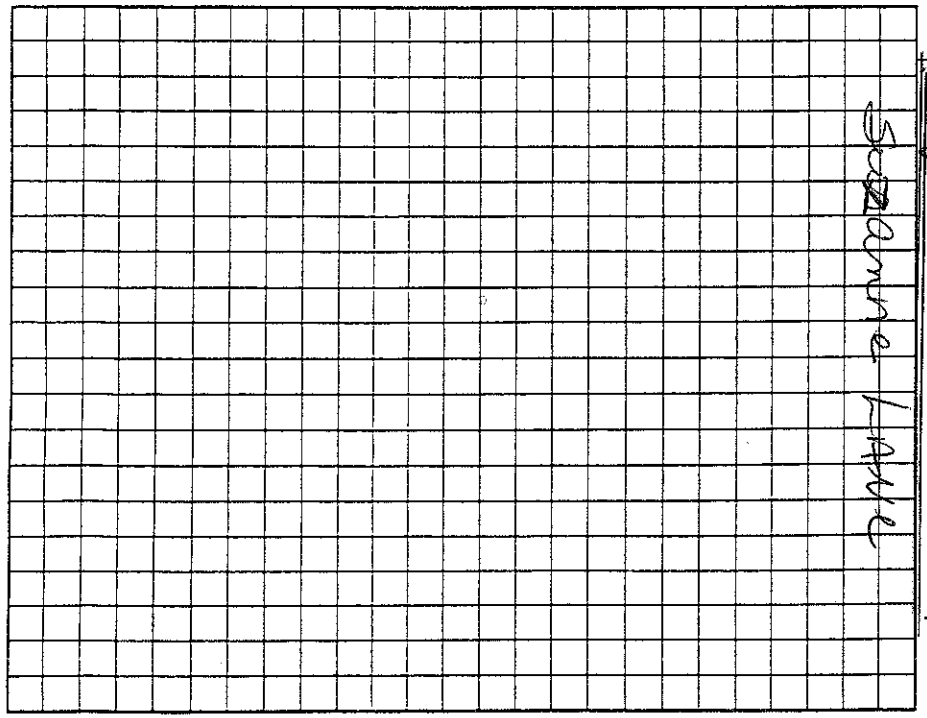

AS BUILT SKETCH

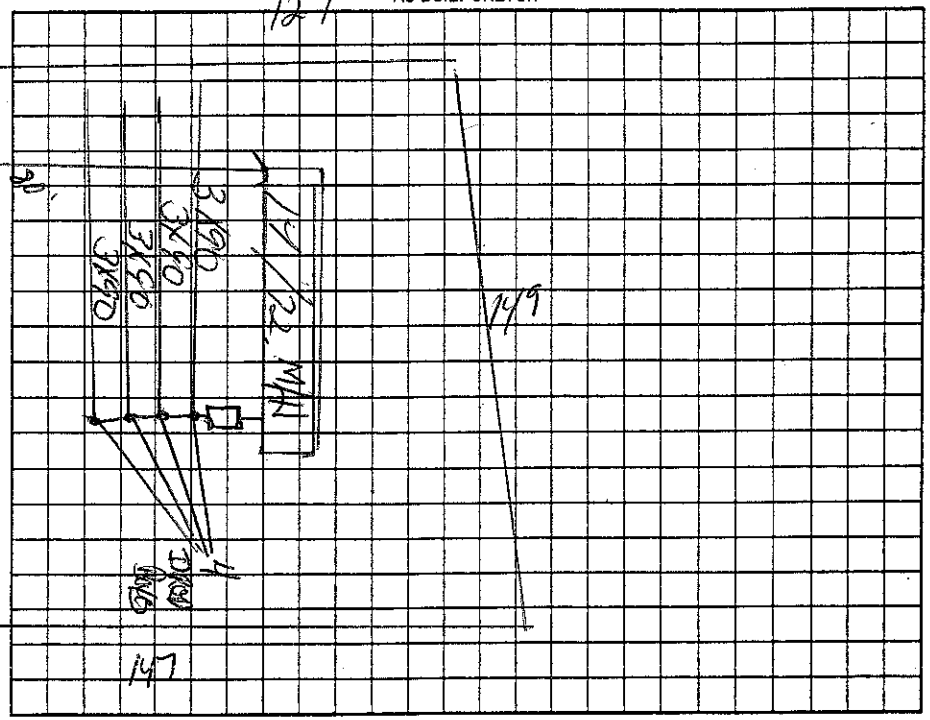

Permit can be suspended or revoked if any false information is supplied toward securing the permit/any unauthorized changes are made to the site/any unauthorized changes are made in the installation of the system. Improvement Permit with plat valid without expiration. ☐ Improvement Permit with site plan valid for sixty months ☐ Authorization to Construct is valid for a period equal to that of Improvement Permit – not to exceed sixty months.

Signed: _____ date _____

Improvement Permit by: _____ date _____

Authorization to Construct by: _____ date _____

Installed by: _____

Operation Permit by: _____ date _____

Existing System Inspection by: Kelly Cook date 7-7-06

HEALTH DEPT. COPY: WHITE OWNER COPY (FINAL): YELLOW OWNER COPY (INITIAL): PINK