IREDELL COUNTY HEALTH DEPARTMENT - *ENVIRONMENTAL HEALTH* ☒ STATESVILLE OFFICE 704-878-5305 ☐ MOORESVILLE OFFICE 704-664-5281

IMPROVEMENT PERMIT / AUTHORIZATION TO CONSTRUCT / OPERATION PERMIT / EXISTING SYSTEM INSPECTION

PERMIT # 165155 PIN # 4703-80-5215 DATE 2-11-11

OWNER Ronald & Reita Presnell APPLICANT: same PHONE: Home/Cell # 704 664 9734 Business # 704 506 6864

SITE ADDRESS 114 Sebastian Lane OWNER / APPLICANT ADDRESS 365 Judas Road Mooresville, NC 28117

SITE DIRECTIONS I-40W, L on Old Mtn. (R) on E. Lewis Ferry, (L) onto Pinedell Acres (R) on Sebastian on (R)

SUBDIVISION n/d BLOCK / SECTION n/a LOT # n/a LOT AREA 3.57 DESIGN FLOW 480 L.T.A.R. .25

Septic Tank 1000 Gallons: STB 760 Date 12-11 ☒ New System ☐ Repair ☐ Expansion System Type I II III IV V VI

Pump Tank ____ Gallons: P T ____ Date ____ System Description: 25% Reduction Gravity

Pump Make ____ Model ____ Serial # ____ Repair System Description: 35% Reduction Gravity

No. Nitrification Fields: 1 No. Lines 4 Linear Feet 480 Maintenance Agreement Required ☐ YES ☒ NO

Trench Width 36" Max. Trench Bottom Depth 36" Gravel Depth n/a ☒ GRAVITY ☐ PRESSURE

☒ Residence No. Bedrooms 4 ☐ Business No. Persons ____ ☐ Other No. Employees ____ ☐ Slab ☒ Crawl Space ☐ Basement w/plumbing ☐ Basement w/o plumbing


Water Supply: ☐ Private ☒ Public ☐ Community

Comments / Conditions


~~111'~~ 100'

Polyloll Filt—

INITIAL SITE SKETCH

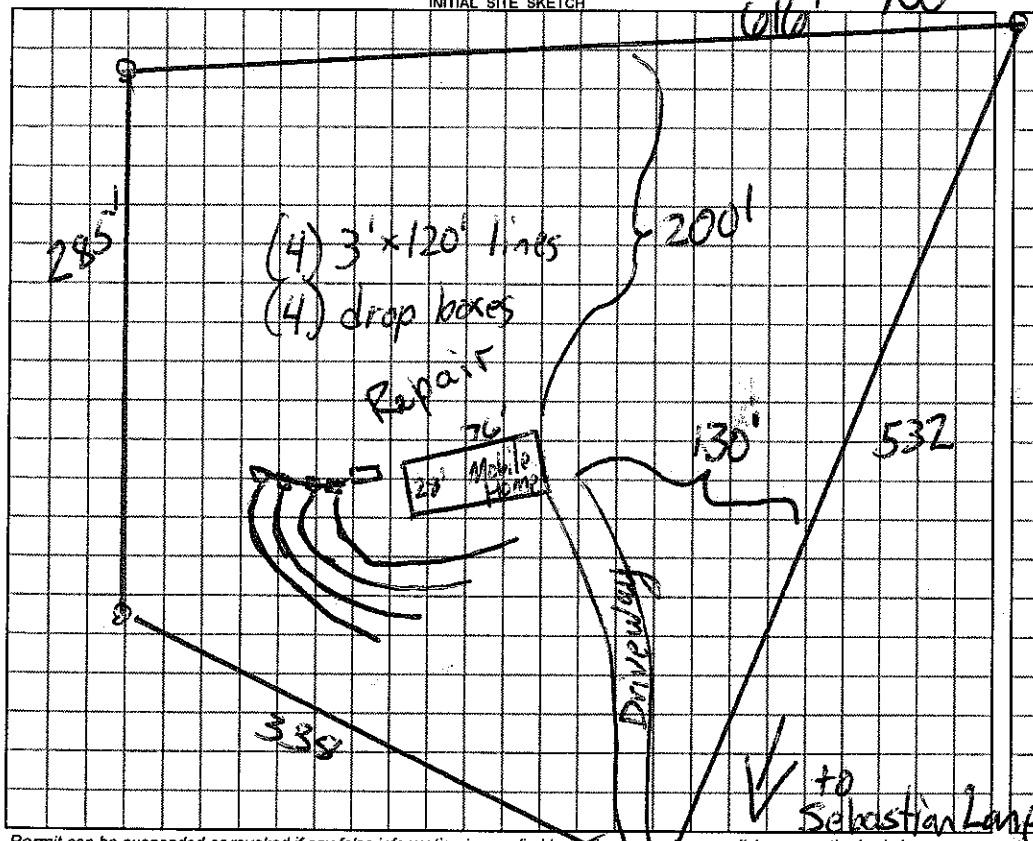

AS BUILT SKETCH

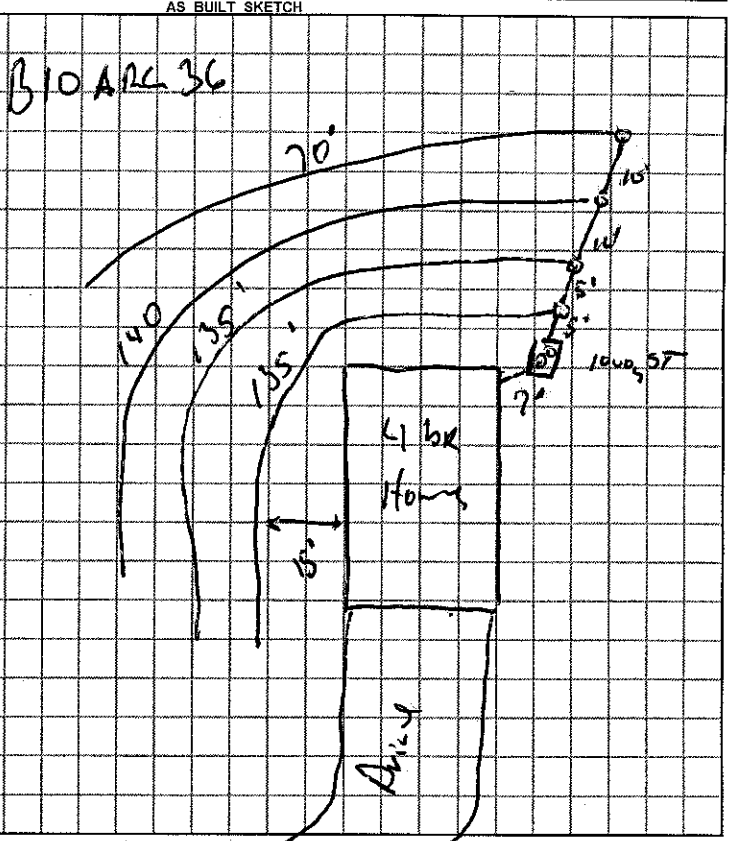

Permit can be suspended or revoked if any false information is supplied toward securing the permit / any unauthorized changes are made to the site / any unauthorized changes are made in the installation of the system.

☐ *IMPROVEMENT PERMIT* with plat valid without expiration ☒ *IMPROVEMENT PERMIT* with plat valid ~~without expiration~~ for 60 mos. ☒ *AUTHORIZATION TO CONSTRUCT* valid for period equal to IMPROVEMENT PERMIT—not to exceed 60 mo.

Owner / Applicant Signature: [signature] Date 2-11-11 Installed by: Abbey Grad

IMPROVEMENT PERMIT by: [signature] REHS Date 2-11-11 OPERATION PERMIT by: [signature] REHS Date 4 Apr 2011

AUTHORIZATION TO CONSTRUCT by: [signature] REHS Date 2-11-11 Existing System Inspected by: ____ REHS Date ____

YOU SHOULD CONTACT A LOCATOR SERVICE PRIOR TO ANY EXCAVATION

White Copy – Environmental Health YELLOW COPY (Final) Owner / Applicant PINK COPY (Initial) Owner / Applicant