IREDELL COUNTY HEALTH DEPARTMENT

STATESVILLE 704-878-5305 (C1) MOORESVILLE 704-664-5281

IMPROVEMENT PERMIT / AUTHORIZATION TO CONSTRUCT / OPERATION PERMIT / EXISTING SYSTEM INSPECTION

PERMIT# 106535 PIN# 4703-80-6084.5 DATE 7-26-03

OWNER OR CONTRACTOR CLAUDETTE BALLARD PHONE: Business 704-450-1088 Home 704-878-6772

ADDRESS 2032 HAZELWOOD DRIVE, STATESVILLE, NC 28625

LOCATION I-40W, TL OLD MTN. RD, TR LEWIS FERRY RD, TL PINEDELL, TR SEBASTIAN LANE, 450' on RIGHT

SUBDIVISION JEFFERSON LANDING BLOCK / SECTION II LOT 19 LOT AREA 1.172 ACRES SITE CLASS. PS' DESIGN FLOW 360 L.T.A.R. 0.30 GAD/FT2

Septic Tank: 1000 Gallons; STB B25 Date 1-4-05

Pump Tank: _____ Gallons; PT _____ Date _____

Pump Make: _____ Model _____ Serial No. _____

Nitrification Field: No Fields 1 Square Feet EQ TO 1200 Linear Feet 200

No Lines FOUR Trench Width 24" Max Trench Bottom Depth 36"

☑ New System ☐ Repair System Type: I, II, (III), IV, V, VI

System Description: 50% REDUCTION, GRAVITY

Repair System Description: 50% REDUCTION, LOW PRESSURE

Maintenance Agreement Required: ☐ Yes ☑ No

Gravel Depth SAND 24" ☐ Slab ☑ Crawl Space ☐ Basement w/plumbing ☐ Basement wo/plumbing


☐ House/Mod. Home ☑ Mobile Home ☐ Business ☐ Other

No. Bedrooms 3 No. Bathrooms 2 No. Employees ____

Water Supply: ☐ Individual ☑ Public ☐ Community

Comments:/Conditions: (1) USE THREE FLOW DIVIDER TEES TO ACHIEVE EQUAL DISTRIBUTION (2) INSTALL SUBSURFACE INTERCEPT DRAINAGE DITCH 48" DEEP (3) INSTALL 50% REDUCTION SYSTEM USING 48' PPBRS PANELS

INITIAL SITE SKETCH

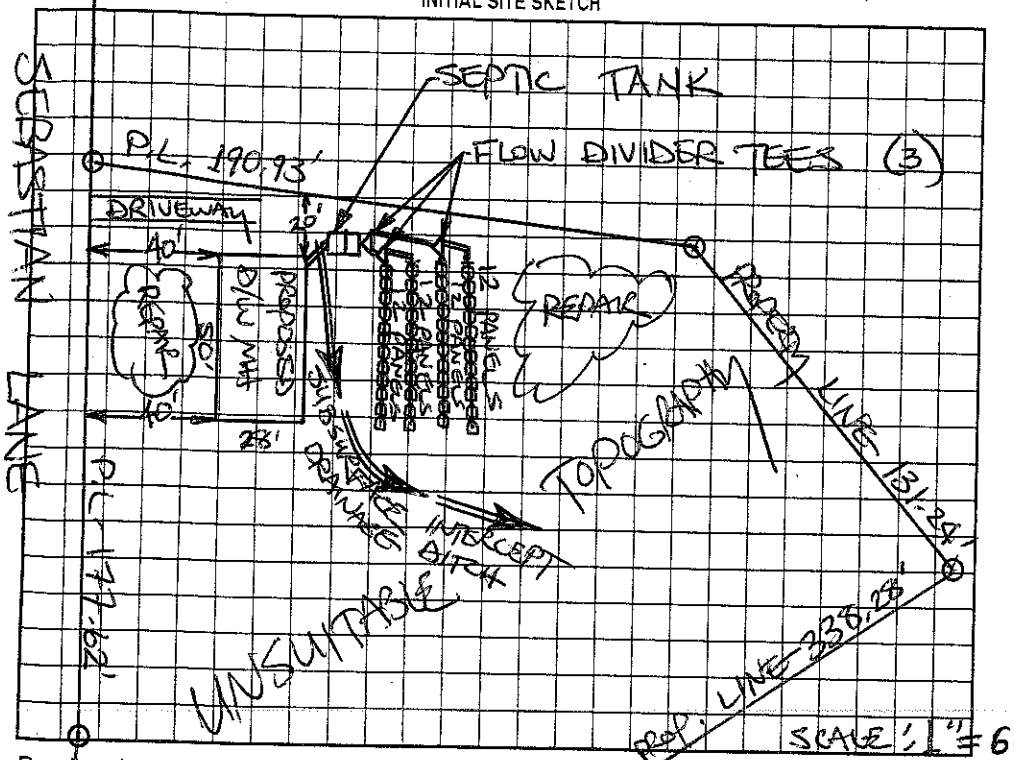

Comments:/Conditions: APPROVED 28'X64' PLAN: KEEP LEFT SIDE OF HOME 20' OFF P/L & EXTEND RIGHT SIDE OF HOME TOWARDS U/S TOPO

AS BUILT SKETCH

SEPTIC TANK WITH MARKER INSTALLED USING "POLY LOK" FILTER

SYSTEM INSTALLED ACCORDING TO INITIAL SITE SKETCH

Permit can be suspended or revoked if any false information is supplied toward securing the permit/any unauthorized changes are made to the site/any unauthorized changes are made in the installation of the system. Improvement Permit with plat valid without expiration. Improvement Permit with site plan valid for sixty months. Authorization to Construct is valid for a period equal to that of Improvement Permit – not to exceed sixty months.

Signed: Claudette Ballard date 7/28/03 Installed by: ROWAN SEPTIC

Improvement Permit by: STEVE HEDRICK date 7-26-03 Operation Permit by: STEVE HEDRICK date 3-10-05

Authorization to Construct by: _____ date 11-19-04 Existing System Inspection by: _____ date _____

HEALTH DEPT. COPY: WHITE OWNER COPY (FINAL): YELLOW OWNER COPY (INITIAL): PINK