IREDELL COUNTY HEALTH DEPARTMENT

STATESVILLE 704-878-5305 MOORESVILLE 704-664-5281

IMPROVEMENT PERMIT / AUTHORIZATION TO CONSTRUCT / OPERATION PERMIT / EXISTING SYSTEM INSPECTION

PERMIT# 9/474 PIN# 4702895559 DATE 10/3/00

OWNER OR CONTRACTOR CLAUDETTE BALLARD PHONE: Business 878-6772 Home

ADDRESS 2032 HAZELWOOD DR STATESVILLE NC 28625

LOCATION OLD MTN RD - TR LEWIS FERRY - TL PINE DELL AC - TR JEFFERSON - ON LT

SUBDIVISION JEFFERSON LNDG BLOCK / SECTION LOT 2 LOT AREA .5AC SITE CLASS PS DESIGN FLOW 360 GPD L.T.A.R. .25 gpd/ft²

Septic Tank: 1000 Gallons; STB 620 Date 8/15/00
Pump Tank: Gallons; PT Date
Pump Make: Model Serial No.
Nitrification Field: No Fields 1 Square Feet 1080 Linear Feet 360
No Lines 4@90' Trench Width 36" Max Trench Bottom Depth 24" Gravel Depth N/A

☑ New System ☐ Repair System Type: I, II, (III), IV, V, VI
System Description: GRAVITY 25% REDUCTION
Repair System Description: PANEL GRAV/PUMP
Maintenance Agreement Required: ☐ Yes ☑ No


☑ House/Mod. Home No. Bedrooms 3
☐ Mobile Home No. Bathrooms 2
☐ Business No. Employees
☐ Other
☐ Slab ☑ Crawl Space ☐ Basement w/plumbing ☐ Basement wo/plumbing

Water Supply: ☐ Individual ☑ Public ☐ Community


Comments/Conditions:

Comments/Conditions:

INITIAL SITE SKETCH 1"=40'

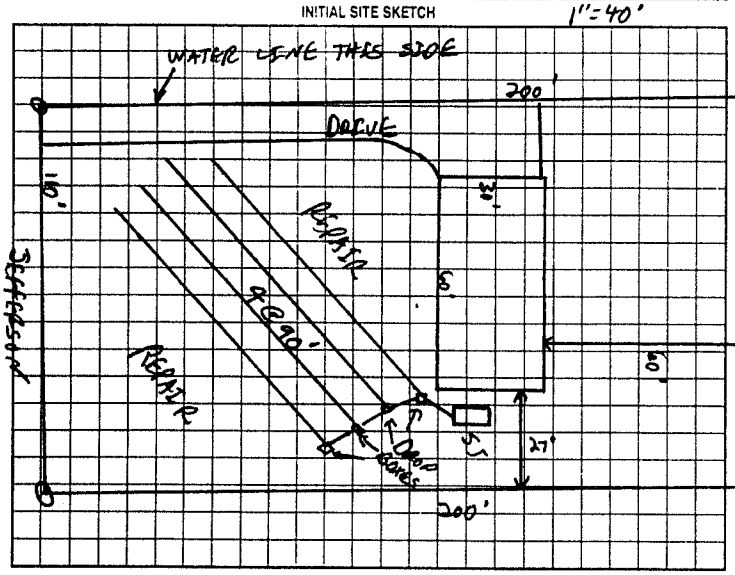

AS BUILT SKETCH

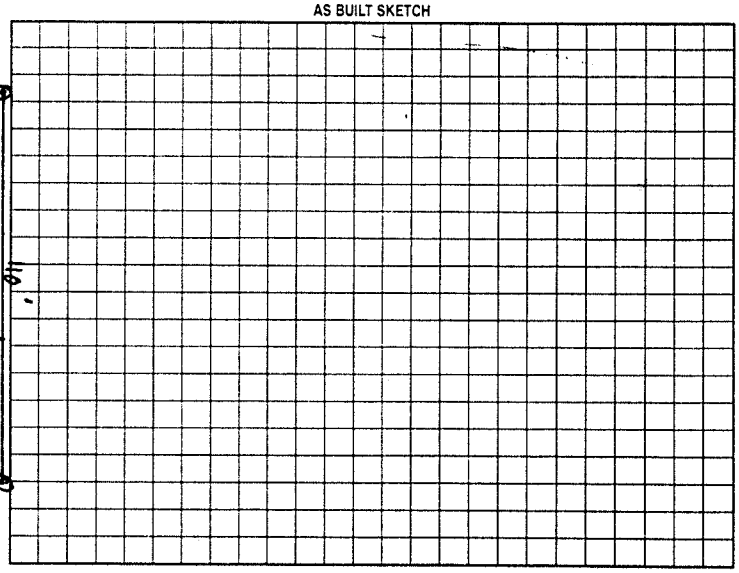

Permit can be suspended or revoked if any false information is supplied toward securing the permit/any unauthorized changes are made to the site/any unauthorized changes are made in the installation of the system. Improvement Permit with plat valid without expiration. Improvement Permit with site plan valid for sixty months. Authorization to Construct is valid for a period equal to that of Improvement Permit - not to exceed sixty months.

Signed: Claudette Ballard date 10/3/2000 Installed by: KENNY MAISEL

Improvement Permit by: C. Bly RS date 10/3/00 Operation Permit by: C. Bly RS date 10/3/00

Authorization to Construct by: C. Bly RS date 10/3/00 Existing System Inspection by: date

HEALTH DEPT. COPY WHITE OWNER COPY (FINAL) YELLOW OWNER COPY (INITIAL) PINK