IREDELL COUNTY HEALTH DEPARTMENT

STATESVILLE 704-878-5305 MOORESVILLE 704-664-5281

IMPROVEMENT PERMIT / AUTHORIZATION TO CONSTRUCT / OPERATION PERMIT / EXISTING SYSTEM INSPECTION

PERMIT# 79103 PIN# 4703 82 9908 DATE 2-5-99

OWNER OR CONTRACTOR Larry Hall PHONE: Business Home 872 0435

ADDRESS 115 Tweety LN

LOCATION E. Lewis Ferry Turn Grace Lynn TL S Lynn Hollow at 1st Rt.

SUBDIVISION Three Oaks BLOCK / SECTION 1 LOT 62 LOT AREA .94acres SITE CLASS PS DESIGN FLOW 360 L.T.A.R. .33

Septic Tank: 1000 Gallons; STB 794 Date 3-13-99
Pump Tank: Gallons; PT Date
Pump Make: Model Serial No.
Nitrification Field: No Fields 1 Square Feet 1080 Linear Feet 360
No Lines 3 Trench Width 36" Max Trench Bottom Depth 36" Gravel Depth 12"

☑ New System ☐ Repair System Type: I II III IV V VI
System Description: Conv. Gravity
Repair System Description: Gravity 2590 Ref
Maintenance Agreement Required: ☐ Yes ☑ No


☑ House/Mod. Home No. Bedrooms 3
☐ Mobile Home No. Bathrooms 2
☐ Business No. Employees
☐ Other
☐ Slab ☐ Crawl Space ☑ Basement w/plumbing ☐ Basement wo/plumbing

Water Supply: ☐ Individual ☑ Public ☐ Community


Comments/Conditions:

Comments/Conditions:

INITIAL SITE SKETCH

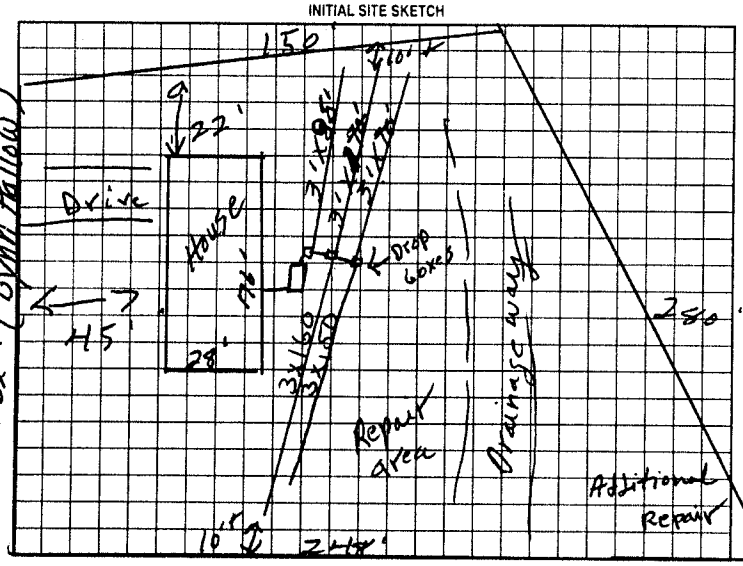

AS BUILT SKETCH

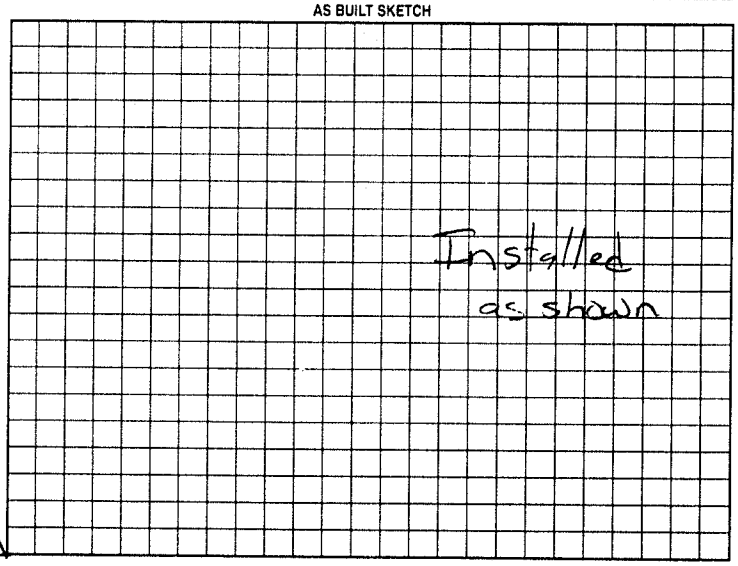

Permit can be suspended or revoked if any false information is supplied toward securing the permit/any unauthorized changes are made to the site/any unauthorized changes are made in the installation of the system. Improvement Permit with plat valid without expiration. Improvement Permit with site plan valid for sixty months. Authorization to Construct is valid for a period equal to that of Improvement Permit – not to exceed sixty months.

Signed: X Larry Hall date

Improvement Permit by: P. C. Moore date 2-5-99

Authorization to Construct by: P. C. Moore date 2-5-99

Installed by: Dale Wingler

Operation Permit by: Mary C Ott TS date 5-27-99

Existing System Inspection by: date

HEALTH DEPT COPY WHITE OWNER COPY (FINAL) YELLOW OWNER COPY (INITIAL) PINK