IREDELL COUNTY HEALTH DEPARTMENT

12:00

STATESVILLE 704-878-5305 MOORESVILLE 704-664-5281

IMPROVEMENT PERMIT / AUTHORIZATION TO CONSTRUCT / OPERATION PERMIT / EXISTING SYSTEM INSPECTION

PERMIT# 73006 PIN# 4703 93 1769 DATE 4-23-98

OWNER OR CONTRACTOR Mark Harrington PHONE: Business Home 876 1066

ADDRESS PO Box 653 Sta NC.

LOCATION 112 Parkers Grove Ln I-40 W TL onto R TR Lewis Ferry TR Grove Lynn TR Parker Pl 1st left

SUBDIVISION 3 oaks BLOCK / SECTION LOT 47 LOT AREA .98 acres SITE CLASS. PS DESIGN FLOW 480 L.T.A.R. 1.3

Septic Tank: 1000 Gallons; STB 794 Date 7-8-96

Pump Tank: Gallons; PT Date

Pump Make: Model Serial No.

Nitrification Field: No Fields 4 Square Feet 1600 Linear Feet 533

No Lines 4 Trench Width 36" Max Trench Bottom Depth 36" Gravel Depth 12"

☑ New System ☐ Repair System Type: I, II, III, IV, V, VI

System Description: Conv. Gravity

Repair System Description: "

Maintenance Agreement Required: ☐ Yes ☑ No

☑ House/Mod. Home No. Bedrooms 4

☐ Mobile Home No. Bathrooms 3

☐ Business No. Employees

☐ Other

☐ Slab ☐ Crawl Space ☐ Basement w/plumbing ☐ Basement wo/plumbing

Water Supply: ☐ Individual ☑ Public ☐ Community


Comments:/Conditions:

250'


Comments:/Conditions:

Note: Lines end feed NOT split fed.

INITIAL SITE SKETCH

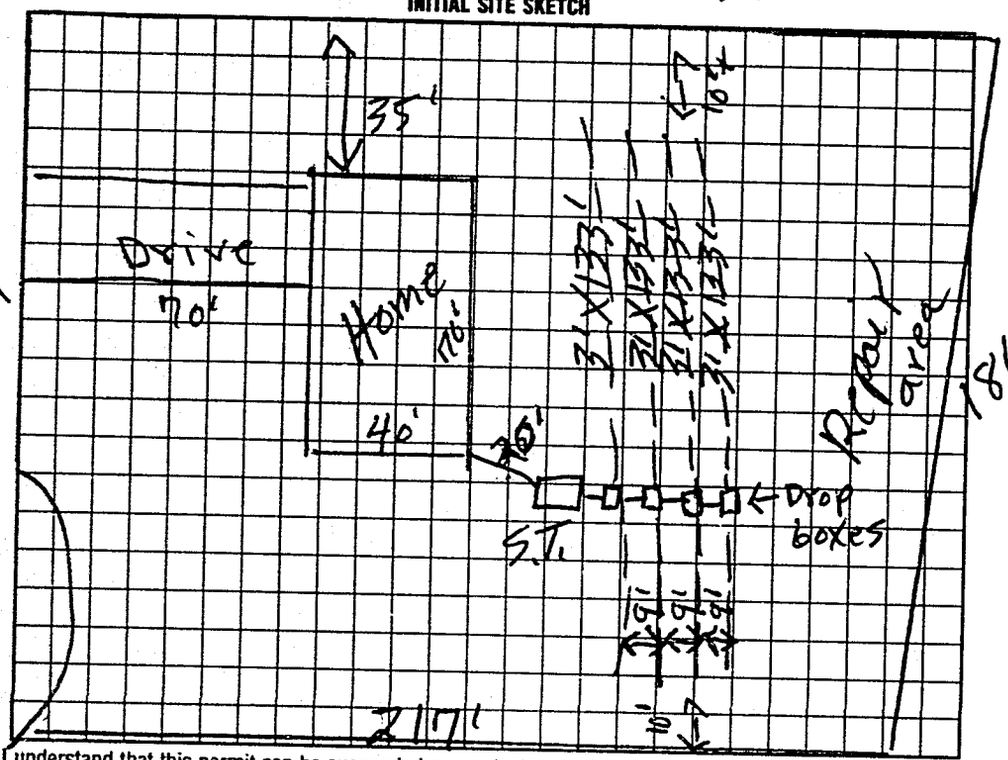

AS BUILT SKETCH

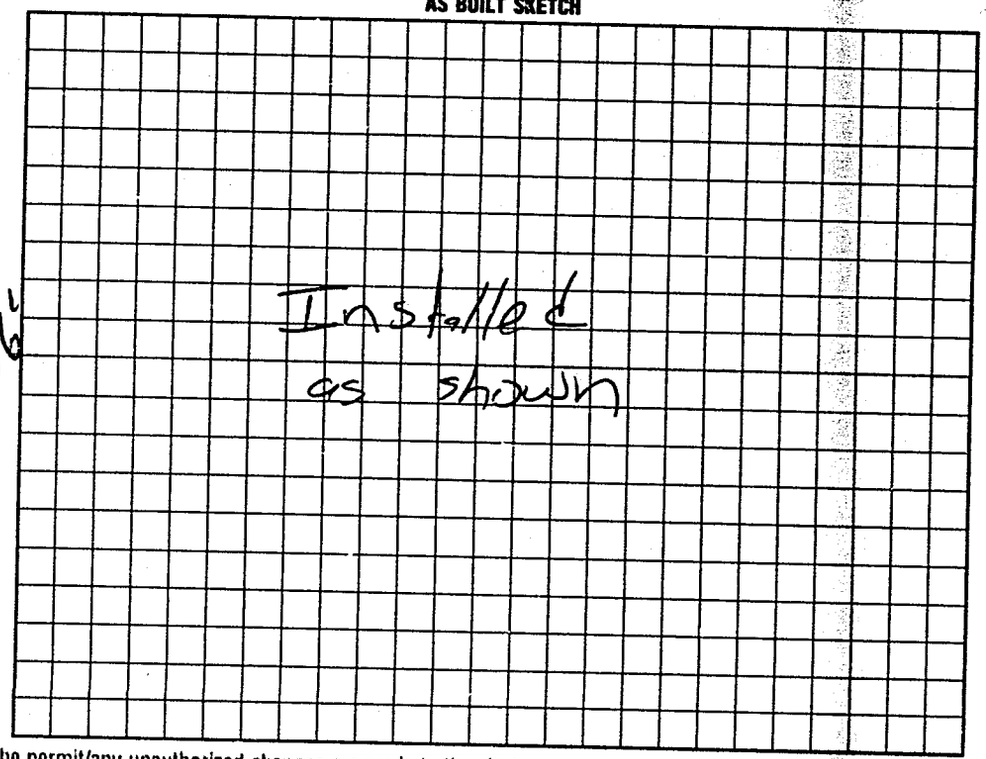

I understand that this permit can be suspended or revoked if any false information is supplied toward securing the permit/any unauthorized changes are made to the site/any unauthorized changes are made in the installation of the system. Improvement Permit with plat valid without expiration. Improvement Permit with site plan valid for sixty months. Authorization to Construct is valid for a period equal to that of Improvement Permit – not to exceed sixty months.

Signed: Mark Harrington date

Improvement Permit by: C. Moore date 4-23-98

Authorization to Construct by: C. Moore date 4-23-98

Installed by: James Hudler

Operation Permit by: Mark C. Oakes date 9-24-98

Existing System Inspection by: date

HEALTH DEPT COPY WHITE INSPECTION COPY (FINAL) GREEN OWNER COPY (FINAL) YELLOW INSPECTION COPY (INITIAL) PINK OWNER COPY (INITIAL): GOLD