IREDELL COUNTY HEALTH DEPARTMENT

STATESVILLE 704-878-5305 MOORESVILLE 704-664-5281

IMPROVEMENT PERMIT / AUTHORIZATION TO CONSTRUCT / OPERATION PERMIT / EXISTING SYSTEM INSPECTION

PERMIT# 97894 PIN# 4703832727 DATE March 6 2000

OWNER OR CONTRACTOR Jerry Price PHONE: Business 878 0330 Home

ADDRESS 239 Lewis Ferry Rd Statesville

LOCATION Lot 46 5th Old Mt Rd (R) Lewis Ferry (R) Grace Lynn (R) Parkers 1st end on left

SUBDIVISION Three Oaks BLOCK / SECTION 3 LOT 46 LOT AREA .89 SITE CLASS PS DESIGN FLOW 360 L.T.A.R. .3

Septic Tank: 1000 Gallons: STB 1012 Date 10-21-2000 ☑ New System ☐ Repair System Type: I II III IV V VI

Pump Tank: Gallons: PT Date

Pump Make: Model Serial No.

Nitrification Field: No Fields 1 Square Feet 1200 Linear Feet 400

No Lines 4 Trench Width 36" Max Trench Bottom Depth 36"

System Description: Conv. Gravity

Repair System Description: Gravity Reduction

Maintenance Agreement Required: ☐ Yes ☑ No

Gravel Depth 12"

☑ House/Mod. Home No. Bedrooms 3

☐ Mobile Home No. Bathrooms 2

☐ Business No. Employees

☐ Other

☐ Slab ☐ Crawl Space ☐ Basement w/plumbing ☑ Basement wo/plumbing


Water Supply: ☐ Individual ☑ Public ☐ Community

Comments:/Conditions:


Comments:/Conditions: - Poly Lok Filter installed
- Tank Riser installed

Not To Scale

INITIAL SITE SKETCH

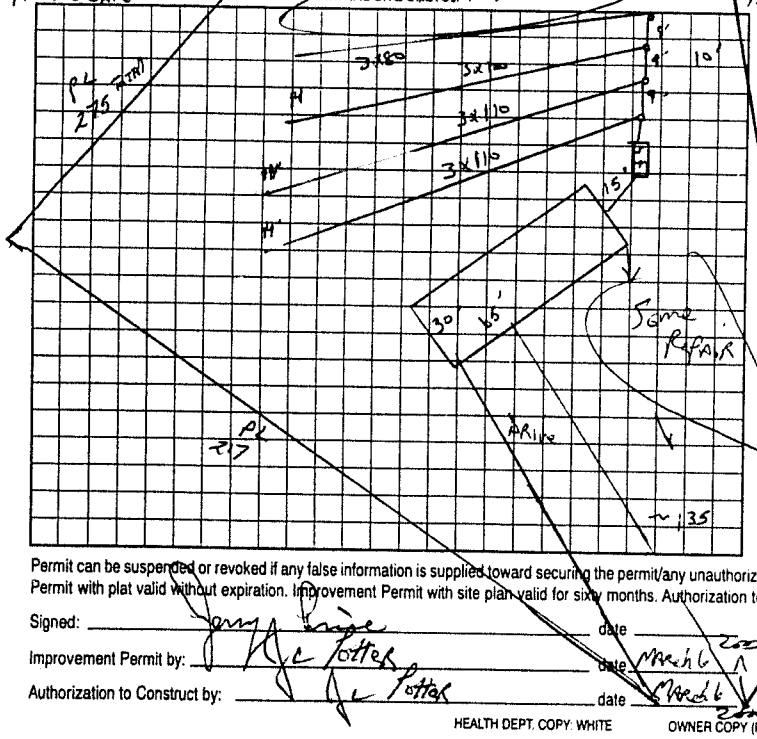

AS BUILT SKETCH

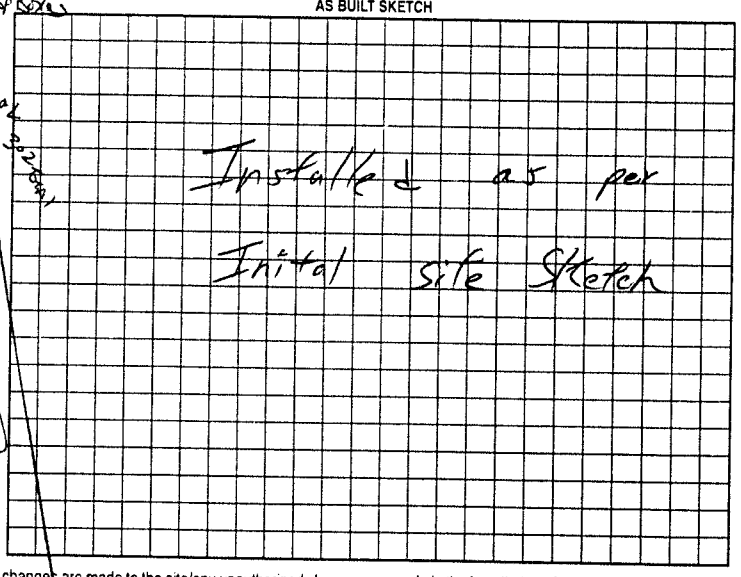

Permit can be suspended or revoked if any false information is supplied toward securing the permit/any unauthorized changes are made to the site/any unauthorized changes are made in the installation of the system. Improvement Permit with plat valid without expiration. Improvement Permit with site plan valid for sixty months. Authorization to Construct is valid for a period equal to that of Improvement Permit – not to exceed sixty months.

Signed: Jerry Price date 3-6-00 Installed by: Dale Gwinner

Improvement Permit by: J.C. Potter date March 6 2000 Operation Permit by: William O. Johnson RSI date 4/11/01

Authorization to Construct by: J.C. Potter date March 6 2000 Existing System Inspection by: date

HEALTH DEPT. COPY: WHITE OWNER COPY (FINAL): YELLOW OWNER COPY (INITIAL) PINK