IREDELL COUNTY HEALTH DEPARTMENT

STATESVILLE 704-878-5305 MOORESVILLE 704-664-5281

IMPROVEMENT PERMIT / AUTHORIZATION TO CONSTRUCT / OPERATION PERMIT / EXISTING SYSTEM INSPECTION

PERMIT# 81943 PIN# 4703833857

OWNER OR CONTRACTOR Jerry Price PHONE: Business 878 0330 Home DATE 6-28-99

ADDRESS

LOCATION 70 W TL onto 239 Lewis Ferry Rd Statesville, N.C.

SUBDIVISION Three oaks BLOCK / SECTION LOT 45 LOT AREA 1.39 acres SITE CLASS PS DESIGN FLOW 360 L.T.A.R. .3

TR Lewis Ferry TR Grace Lynn TR Parkers Grove at End

Septic Tank: 1000 Gallons; STB 312 Date 5-6-99

Pump Tank: Gallons; PT Date

Pump Make: Model Serial No.

Nitrification Field: No Fields 1 Square Feet 1200 Linear Feet 400

No Lines 3 Trench Width 36" Max Trench Bottom Depth 36" Gravel Depth 12"

☑ New System ☐ Repair System Type: I ☐ II ☐ III ☐ IV ☐ V ☐ VI

System Description: Conv. Gravity

Repair System Description: " "

Maintenance Agreement Required: ☐ Yes ☑ No

☑ House/Mod. Home No. Bedrooms 3

☐ Mobile Home No. Bathrooms 2

☐ Business No. Employees


☐ Other

☐ Slab ☐ Crawl Space ☑ Basement w/plumbing ☐ Basement wo/plumbing

Water Supply: ☐ Individual ☑ Public ☐ Community


Comments/Conditions:

INITIAL SITE SKETCH

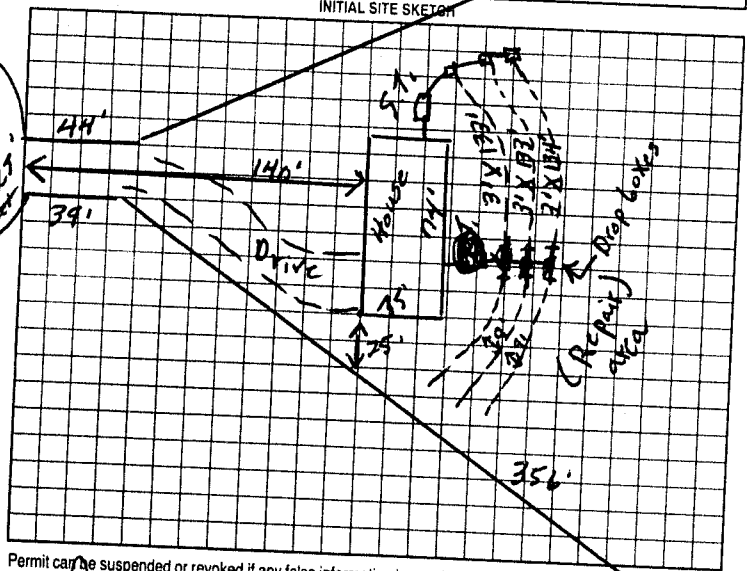

Comments/Conditions:

AS BUILT SKETCH

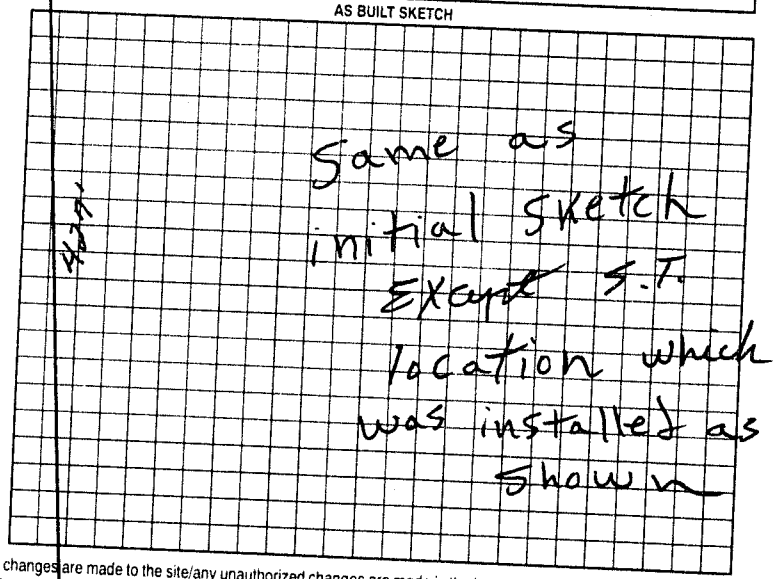

Permit can be suspended or revoked if any false information is supplied toward securing the permit, any unauthorized changes are made to the site/any unauthorized changes are made in the installation of the system. Improvement Permit with plat valid without expiration. Improvement Permit with site plan valid for sixty months. Authorization to Construct is valid for a period equal to that of Improvement Permit – not to exceed sixty months.

Signed: [signature] date 6-29-99 Installed by: Dale Wingler

Improvement Permit by: P. C. Moore date 6-28-99 Operation Permit by: P. C. Moore date 10-1-99

Authorization to Construct by: P. C. Moore date 6-29-99 Existing System Inspection by: date

HEALTH DEPT. COPY WHITE OWNER COPY (FINAL) YELLOW OWNER COPY (INITIAL) PINK