IREDELL COUNTY HEALTH DEPARTMENT

STATESVILLE 704-878-5305 MOORESVILLE 704-664-5281

IMPROVEMENT PERMIT / AUTHORIZATION TO CONSTRUCT / OPERATION PERMIT / EXISTING SYSTEM INSPECTION

PERMIT# 089137 PIN# 4703833406 DATE May 18, 2000

OWNER OR CONTRACTOR Jerry Price PHONE: Business 878-0330 Home

ADDRESS 239 Lewis Ferry Rd. Statesville 28677

LOCATION From Trautman - Old Mtn. Road TL Lewis Ferry Rd TR Grace Lynn TR Parkers Grove At End

SUBDIVISION Three Oaks BLOCK / SECTION 3 LOT 56 LOT AREA 1.08 Ac SITE CLASS RS DESIGN FLOW 360 gpd L.T.A.R. .3+

Septic Tank: 1000 Gallons; STB 1012 Date 5-19-00
Pump Tank: Gallons; PT Date
Pump Make: Model Serial No.
Nitrification Field: No Fields 1 Square Feet 1200 Linear Feet 400
No Lines 3 Trench Width 36" Max Trench Bottom Depth 36"

☑ New System ☐ Repair System Type: I II III IV V VI
System Description: Gravity Conventional
Repair System Description: pumped Innovative
Maintenance Agreement Required: ☐ Yes ☑ No
Gravel Depth 12" ☐ Slab ☑ Crawl Space ☑ Basement w/plumbing ☐ Basement wo/plumbing

☑ House/Mod. Home No. Bedrooms 3
☐ Mobile Home No. Bathrooms 2
☐ Business No. Employees
☐ Other


Water Supply: ☐ Individual ☑ Public ☐ Community

Comments/Conditions: ok to install Basement if desired.

6-15-00 Owner/Builder has built basement in house. Septic Tank Now to be located where ⊗ and drainfield to be centerlined.

Comments/Conditions: DLA- 6-15-00

INITIAL SITE SKETCH 222.51

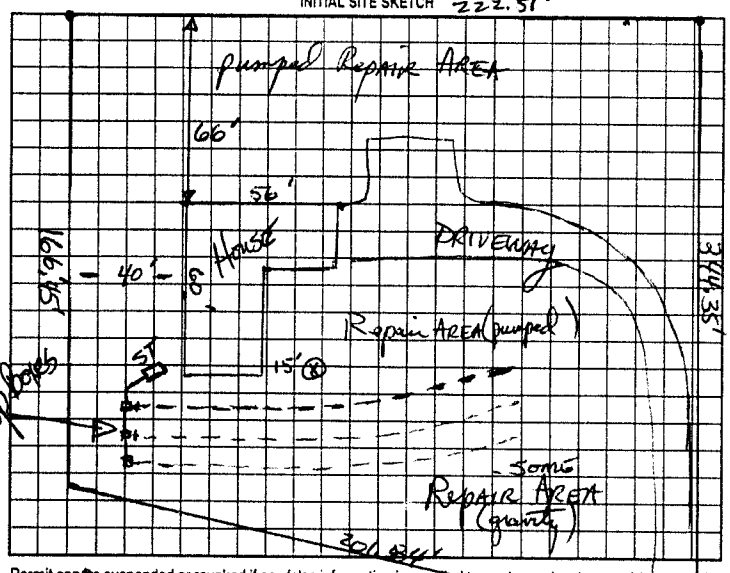

AS BUILT SKETCH

Permit can be suspended or revoked if any false information is supplied toward securing the permit/any unauthorized changes are made to the site/any unauthorized changes are made in the installation of the system. Improvement Permit with plat valid without expiration. Improvement Permit with site plan valid for sixty months. Authorization to Construct is valid for a period equal to that of Improvement Permit – not to exceed sixty months.

Signed: Jerry Price date

Improvement Permit by: Marvel Hunter, RS date 5-18-2000

Authorization to Construct by: Marvel Hunter RS date 5-18-2000

Installed by: Dale Wingler

Operation Permit by: RS date 11-13-00

Existing System Inspection by: date

HEALTH DEPT. COPY: WHITE OWNER COPY (FINAL): YELLOW OWNER COPY (INITIAL): PINK