IREDELL COUNTY HEALTH DEPARTMENT

STATESVILLE 704-878-5305 MOORESVILLE 704-664-5281

IMPROVEMENT PERMIT / AUTHORIZATION TO CONSTRUCT / OPERATION PERMIT / EXISTING SYSTEM INSPECTION

PERMIT# 80453 PIN# 4703834597 DATE 4-8-99

OWNER OR CONTRACTOR Jerry Price PHONE: Business 878 0330 Home

ADDRESS 239 Lewis Ferry Rd Statesville

LOCATION Old Mtn Rd TL Lewis Ferry Rd TR Grace Lynn at end Rt

SUBDIVISION Three Oaks BLOCK / SECTION III LOT 43 LOT AREA .69 acres SITE CLASS PS DESIGN FLOW 360 L.T.A.R. .3

Septic Tank: 1000 Gallons; STB 794 Date 4-3-99
Pump Tank: Gallons; PT Date
Pump Make: Model Serial No.
Nitrification Field: No Fields 1 Square Feet 1200 Linear Feet 400
No Lines 3 Trench Width 36" Max Trench Bottom Depth 36" Gravel Depth 12"

☐ New System ☐ Repair System Type: I II III IV V VI
System Description: Conv. Gravity
Repair System Description: Gravity 259 Rd
Maintenance Agreement Required: ☐ Yes ☑ No


☐ House/Mod. Home No. Bedrooms 3
☐ Mobile Home No. Bathrooms 2
☐ Business No. Employees
☐ Other
☐ Slab ☐ Crawl Space ☐ Basement w/plumbing ☐ Basement wo/plumbing

Water Supply: ☐ Individual ☐ Public ☐ Community


Comments/Conditions:

Comments/Conditions: ① SEPTIC TANK WITH RISERS INSTALLED USING "POLYLOK" FILTER ② LINE #1 INSTALLED BENEATH ONE FOOT OF FILL DIRT

INITIAL SITE SKETCH

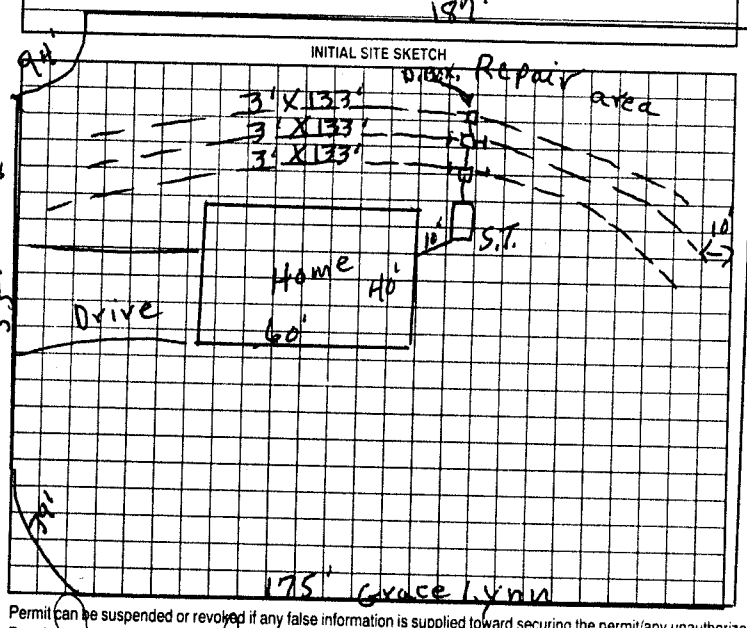

AS BUILT SKETCH

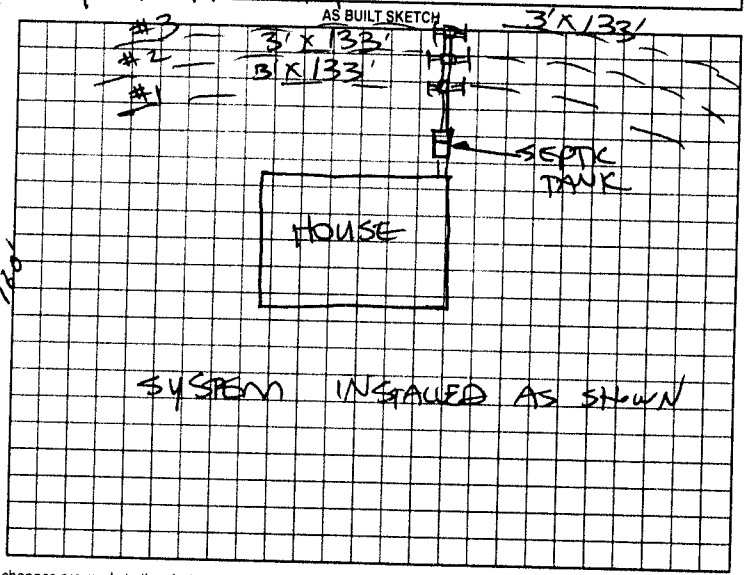

Permit can be suspended or revoked if any false information is supplied toward securing the permit/any unauthorized changes are made to the site/any unauthorized changes are made in the installation of the system. Improvement Permit with plat valid without expiration. Improvement Permit with site plan valid for sixty months. Authorization to Construct is valid for a period equal to that of Improvement Permit – not to exceed sixty months.

Signed: Jerry W Price date 4-8-99

Improvement Permit by: R. C. Moore date 4-8-99

Authorization to Construct by: R. C. Moore date 4-8-99

Installed by: JAMES HUDLER

Operation Permit by: STEVE HEDRICK date 9-13-99

Existing System Inspection by: date

HEALTH DEPT COPY WHITE OWNER COPY (FINAL) YELLOW OWNER COPY (INITIAL) PINK