IREDELL COUNTY HEALTH DEPARTMENT

STATESVILLE 704-878-5305 MOORESVILLE 704-664-5281

IMPROVEMENT PERMIT / AUTHORIZATION TO CONSTRUCT / OPERATION PERMIT / EXISTING SYSTEM INSPECTION

PERMIT# 093666 PIN# 4703 83 6597 DATE 01-18-01

OWNER OR CONTRACTOR JERRY PRICE PHONE: Business Home 878-0330

ADDRESS (LOT) 105 N LYNN HOLLOW DR, STATESVILLE, NC 28677 (HOME) 289 LEWIS FERRY RD, STATESVILLE, NC 28677

LOCATION (LOT 1) OLD MTN RD, R LEWIS FERRY, R GRACE LYNN, AT END

SUBDIVISION 3 OAKS BLOCK / SECTION LOT 42 LOT AREA .69 ACRES SITE CLASS PS DESIGN FLOW 360 spd L.T.A.R. 13 GPD/FT2

Septic Tank: 1000 Gallons: STB 1072 Date 12-10-2000

Pump Tank: Gallons: PT Date

Pump Make: Model Serial No.

Nitrification Field: No Fields 1 Square Feet EQ to 1200' Linear Feet 300'

No Lines 3 Trench Width 36" Max Trench Bottom Depth 36" Gravel Depth N/A

X New System ☐ Repair System Type: I, II, (III) IV, V, VI

System Description: GRAVITY 25% REDUCTION

Repair System Description: PUMP / 50% REDUCTION

Maintenance Agreement Required: ☐ Yes ☐ No

X House/Mod. Home ☐ Mobile Home ☐ Business ☐ Other

No. Bedrooms 3 No. Bathrooms 2 No. Employees


☐ Slab X Crawl Space ☐ Basement w/plumbing ☐ Basement wo/plumbing

Water Supply: ☐ Individual X Public ☐ Community


Comments/Conditions: (1) FOLLOW CONTOURS WITH LINE (2) KEEP SYSTEM 5' off of house & 10' off property lines. (3) KEEP LAST LINE AWAY FROM SMALL DRAINAGE DITCH TO PREVENT FAILURE

Comments/Conditions: (4) Keep H2O Line 10' FROM SYSTEM
- Infiltrator Chambers Installed
- Outlet Filter Installed
- Septic Tank Risers Installed

INITIAL SITE SKETCH 1"=50'

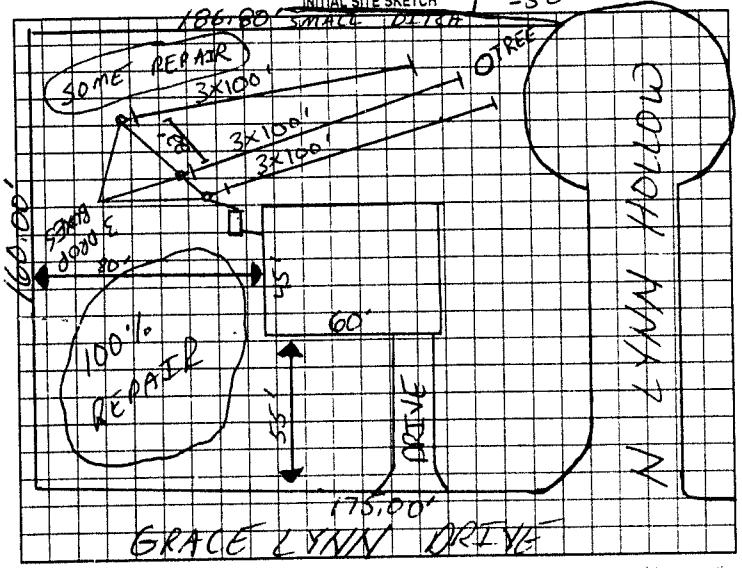

AS BUILT SKETCH

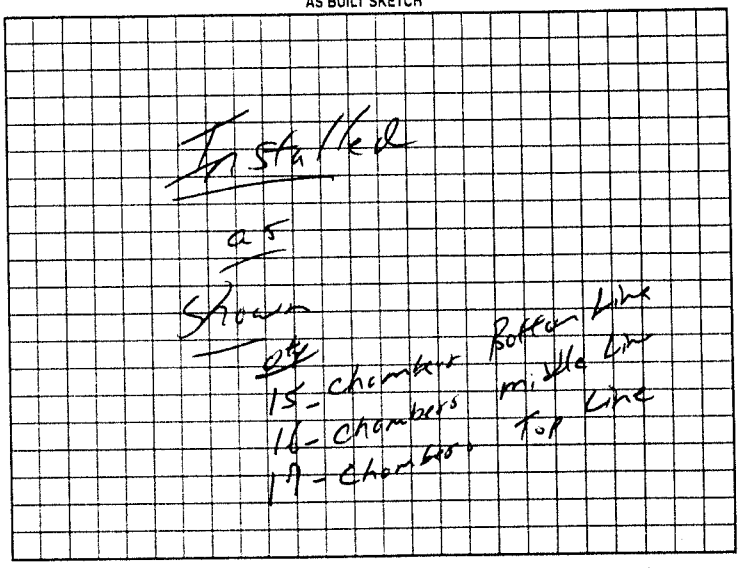

Permit can be suspended or revoked if any false information is supplied toward securing the permit/any unauthorized changes are made to the site/any unauthorized changes are made in the installation of the system. Improvement Permit with plat valid without expiration. Improvement Permit with site plan valid for sixty months. Authorization to Construct is valid for a period equal to that of Improvement Permit – not to exceed sixty months.

Signed: date 1-18-01

Improvement Permit by: RST date 01-18-01

Authorization to Construct by: RSI date 01-18-01

Installed by: Dale Winkler

Operation Permit by: William O. Johnson RSI date 5-18-01

Existing System Inspection by: date

HEALTH DEPT COPY: WHITE OWNER COPY (FINAL): YELLOW OWNER COPY (INITIAL): PINK