4:00

IREDELL COUNTY HEALTH DEPARTMENT

STATESVILLE 704-878-5305 MOORESVILLE 704-664-5281

IMPROVEMENT PERMIT / AUTHORIZATION TO CONSTRUCT / OPERATION PERMIT / EXISTING SYSTEM INSPECTION

PERMIT# 87895 PIN# 4703836799 DATE March 6 2000

OWNER OR CONTRACTOR Jerry Price PHONE: Business 878 0330 Home

ADDRESS 239 Lewis Ferry Rd Statesville

LOCATION South old Mill Rd (R) E Lewis Ferry (R) Gracelynn (R) N. Lynn Hollow on Left

SUBDIVISION Three Oaks BLOCK / SECTION 3 LOT #341 LOT AREA 1.17 SITE CLASS PS DESIGN FLOW 360 L.T.A.R. .3 / .35 Repair

Septic Tank: 1000 Gallons; STB 1012 Date 3/20/00 ☒ New System ☐ Repair System Type: I. II. III. IV. V. VI

Pump Tank: Gallons; PT Date

Pump Make: Model Serial No.

Nitrification Field: No Fields 1 Square Feet 1200 Linear Feet 400

No Lines 7 Trench Width 36" Max Trench Bottom Depth 30-36" Gravel Depth 12"

System Description: Conv. Gravity

Repair System Description: Reduction Loss, blk Shallow

Maintenance Agreement Required: ☐ Yes ☐ No

☒ House/Mod. Home ☐ Mobile Home ☐ Business ☐ Other

No. Bedrooms 3 No. Bathrooms 2 No. Employees


☐ Slab ☐ Crawl Space ☒ Basement w/plumbing ☐ Basement wo/plumbing

Water Supply: ☐ Individual ☒ Public ☐ Community


Comments/Conditions: INSTALL on CONTOUR
Follow All setback Rules May use flow divider Tee
PL 350

Comments/Conditions: Poly lok filter
#1 out of TANK split to #2 + #3 feeding Top 4 Fifty Ft Lines. Bottom 3 Lines feed 2 Sixty Ft Lns + 80 Ft Line from D Box

NOT TO SCALE INITIAL SITE SKETCH 7 bdrm Bedrms

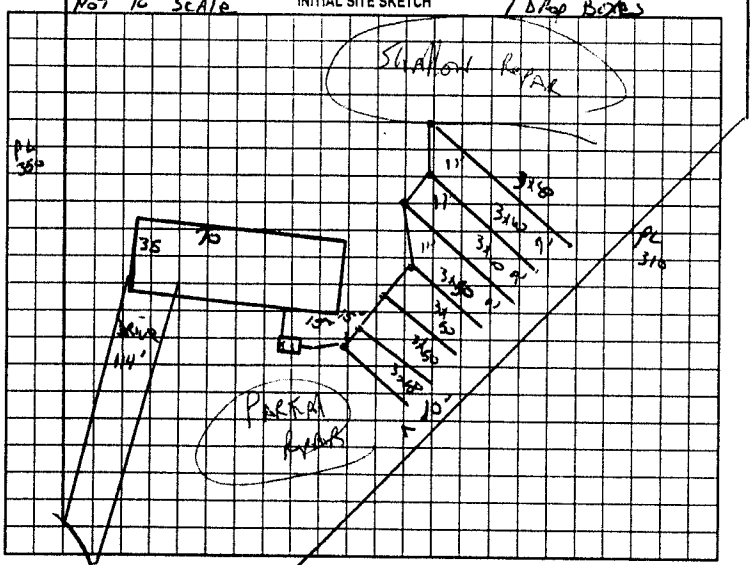

AS BUILT SKETCH Call 928-6030 if questions

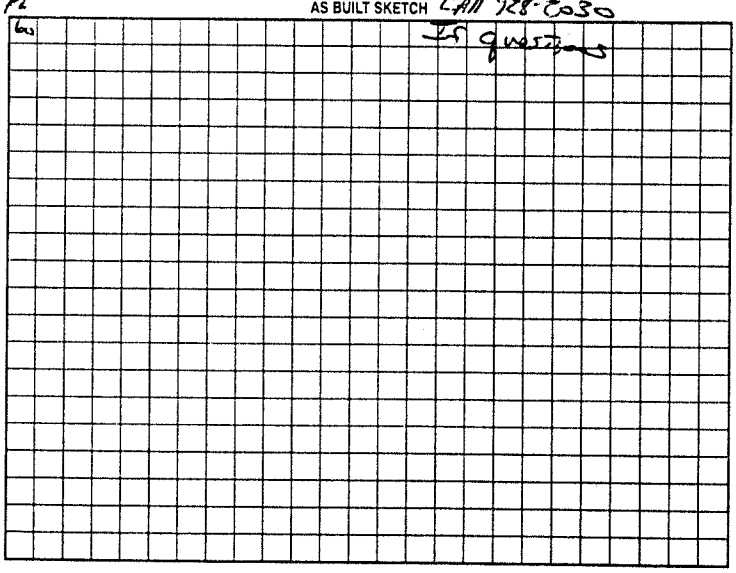

Permit can be suspended or revoked if any false information is supplied toward securing the permit/any unauthorized changes are made to the site/any unauthorized changes are made in the installation of the system. Improvement Permit with ~~plat~~ valid without expiration. Improvement Permit with site plan valid for sixty months. Authorization to Construct is valid for a period equal to that of Improvement Permit – not to exceed sixty months.

Signed: date Installed by: Dale Wingler

Improvement Permit by: date March 6 2000 Operation Permit by: RST date 11/6/00

Authorization to Construct by: date March 6 2000 Existing System Inspection by: date

HEALTH DEPT. COPY. WHITE OWNER COPY (FINAL). YELLOW OWNER COPY (INITIAL) PINK