IREDELL COUNTY HEALTH DEPARTMENT

STATESVILLE 704-878-5305 MOORESVILLE 704-664-5281

IMPROVEMENT PERMIT / AUTHORIZATION TO CONSTRUCT / OPERATION PERMIT / EXISTING SYSTEM INSPECTION

PERMIT# 126298 PIN# 4703839767 DATE 2/28/05

OWNER OR CONTRACTOR Jerry Price PHONE: Business 704 8780330 Home

ADDRESS 239 Lewis Ferry Rd Statesville NC 28677

LOCATION OMR, TR Lewis Ferry, TR Grace Lynn, TR N. Lynn Holland at end on Rt.

SUBDIVISION Three Oaks BLOCK / SECTION LOT 39 LOT AREA 0.98AC SITE CLASS PS DESIGN FLOW 360 L.T.A.R. 0.3

Septic Tank: 1000 Gallons; STB 1012 Date 11-29-04
Pump Tank: Gallons; PT Date
Pump Make: Model Serial No.
Nitrification Field: No Fields 1 Square Feet 1200 Linear Feet 400
No Lines 4 Trench Width 36" Max Trench Bottom Depth 36" Gravel Depth 12"

☒ New System ☐ Repair System Type: I, II, III, IV, V, VI
System Description: Gravity Conventional
Repair System Description: Pump 25% Reduct.
Maintenance Agreement Required: ☐ Yes ☒ No


☒ House/Mod. Home No. Bedrooms 3
☐ Mobile Home No. Bathrooms
☐ Business No. Employees
☐ Other

☐ Slab ☐ Crawl Space ☒ Basement w/plumbing ☐ Basement wo/plumbing

Water Supply: ☐ Individual ☒ Public ☐ Community


Comments:/Conditions:
1"=50'

INITIAL SITE SKETCH

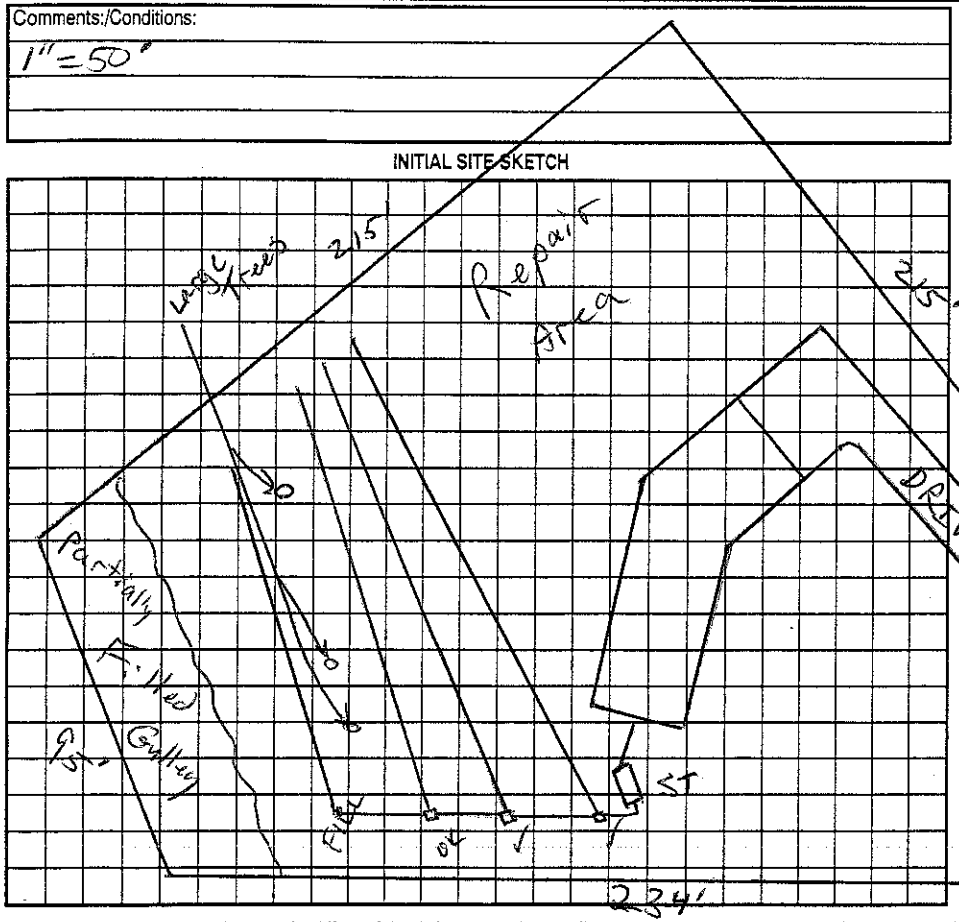

Comments:/Conditions: OWNER CALLED & STATED LAST LINE IS IN FILL DIRT. OK'D 25% REDUCTION & 3x100' LINES. FOLLOWS NEW RULE CHANGE AS Approved Alternative System, LC 6-29-05 ALSO OK'D MOVING TANK WITHOUT ALTERING LINES

AS BUILT SKETCH

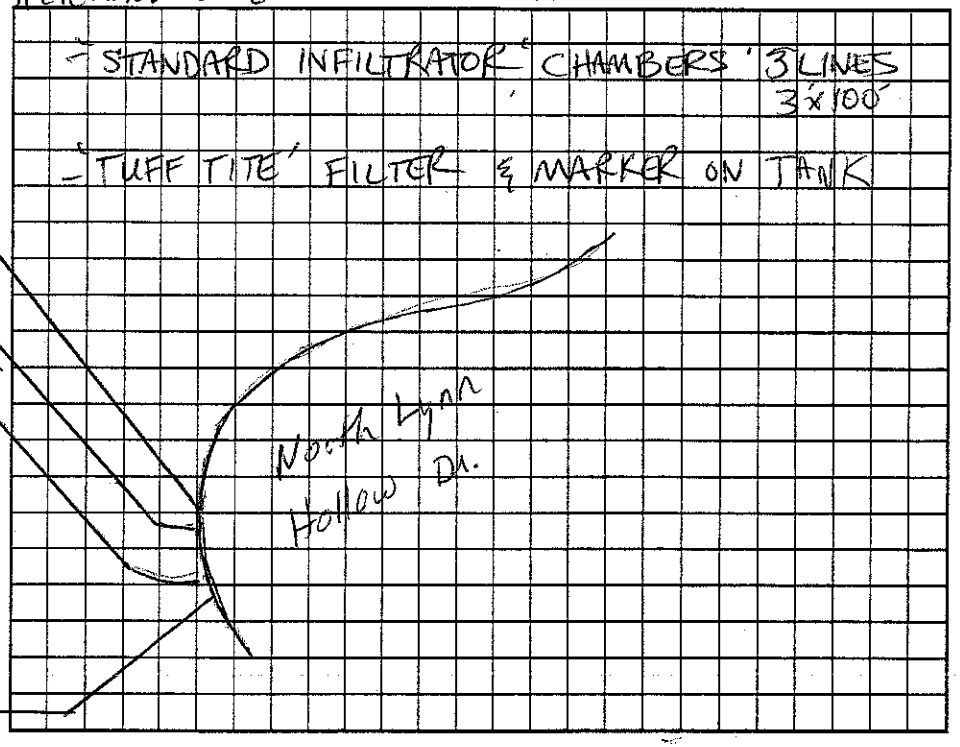

Permit can be suspended or revoked if any false information is supplied toward securing the permit/any unauthorized changes are made to the site/any unauthorized changes are made in the installation of the system. Improvement Permit with plat valid without expiration. Improvement Permit with site plan valid for sixty months. Authorization to Construct is valid for a period equal to that of Improvement Permit – not to exceed sixty months.

Signed: date 3-2-05 Installed by: DAVE WINGLER

Improvement Permit by: RS date 2/28/05 Operation Permit by: RS date 6-30-05

Authorization to Construct by: RS date 2/28/05 Existing System Inspection by: date

HEALTH DEPT. COPY: WHITE OWNER COPY (FINAL): YELLOW OWNER COPY (INITIAL): PINK