IREDELL COUNTY HEALTH DEPARTMENT

STATESVILLE 704-878-5305 MOORESVILLE 704-664-5281

IMPROVEMENT PERMIT / AUTHORIZATION TO CONSTRUCT / OPERATION PERMIT / EXISTING SYSTEM INSPECTION

PERMIT# 79502 PIN# 4703-84-3117

OWNER OR CONTRACTOR Jerry Price PHONE: Business 878 0330 Home

DATE 3-2-99

ADDRESS

LOCATION South off mtn 239 Lewis Ferry Rd

SUBDIVISION Three oaks BLOCK / SECTION LOT 17 LOT AREA 1.43 acres SITE CLASS PS DESIGN FLOW 360 L.T.A.R. .3

Septic Tank: 1000 Gallons; STB 194 Date 1-19-99

Pump Tank: Gallons; PT Date

Pump Make: Model Serial No.

Nitrification Field: No Fields 1 Square Feet 900 Linear Feet 300

No Lines 3 Trench Width 36" Max Trench Bottom Depth 36

☑ New System ☐ Repair System Type: I II III IV V VI

System Description: Gravity 25% Red

Repair System Description:

Maintenance Agreement Required: ☐ Yes ☐ No

☑ House/Mod. Home No. Bedrooms 3

☐ Mobile Home No. Bathrooms 2

☐ Business No. Employees

☐ Other

☐ Slab ☐ Crawl Space ☐ Basement w/plumbing ☑ Basement wo/plumbing

Gravel Depth

Water Supply: ☐ Individual ☑ Public ☐ Community

Comments/Conditions:


240'

Stream


Comments/Conditions

Basement Plumbing must be Pumped up to upper level To S.T.

INITIAL SITE SKETCH

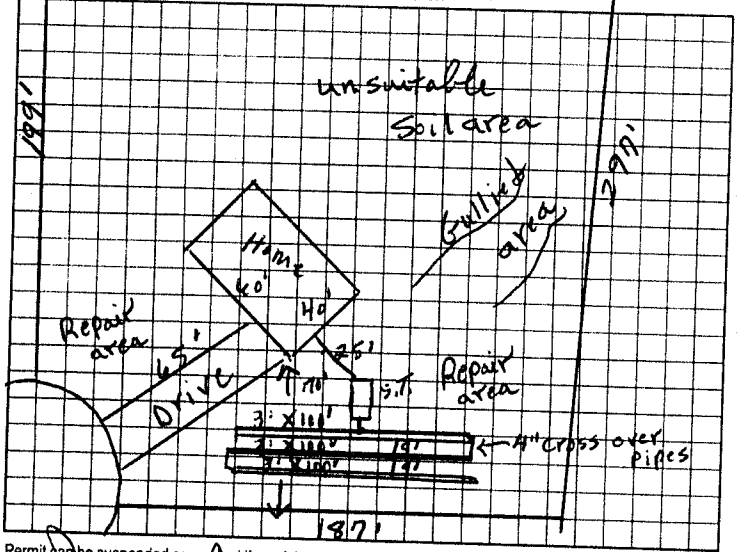

AS BUILT SKETCH

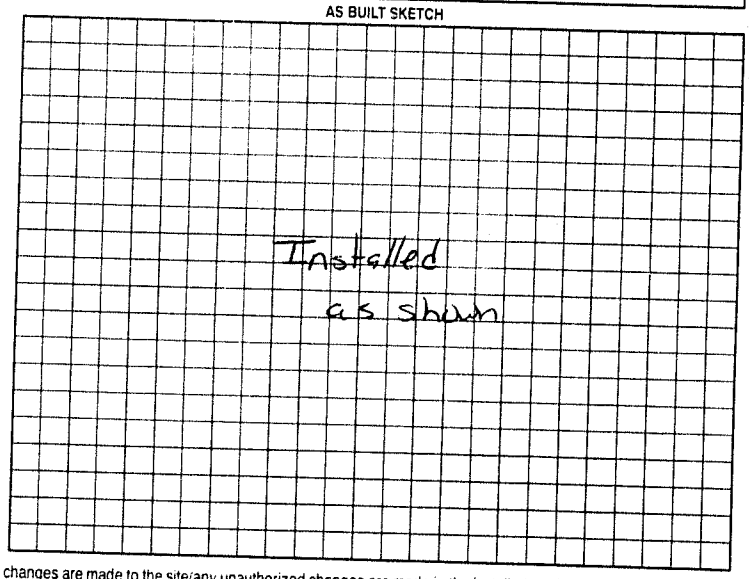

Permit can be suspended or revoked if any false information is supplied toward securing the permit/any unauthorized changes are made to the site/any unauthorized changes are made in the installation of the system. Improvement Permit with plat valid without expiration. Improvement Permit with site plan valid for sixty months. Authorization to Construct is valid for a period equal to that of Improvement Permit - not to exceed sixty months.

Signed: date

Improvement Permit by: R. C. Moore date 3-2-99

Authorization to Construct by: R. C. Moore date 3-2-99

Installed by: James Hudlow

Operation Permit by: Mary C Coff RS date 7-16-99

Existing System Inspection by: date

HEALTH DEPT COPY WHITE OWNER COPY (FINAL) YELLOW OWNER COPY (INITIAL) PINK