IREDELL COUNTY HEALTH DEPARTMENT

STATESVILLE 704-878-5305 (1) MOORESVILLE 704-664-5281

IMPROVEMENT PERMIT / AUTHORIZATION TO CONSTRUCT / OPERATION PERMIT / EXISTING SYSTEM INSPECTION

PERMIT# 120301 PIN# 4703-84-3304.000 | 4422 DATE 6-4-04

OWNER OR CONTRACTOR DAVID & LELESTE STEVENS PHONE: Business 704-902-7995 BUILDER Home 704-871-1035

ADDRESS 228 SCOTTS CREEK RD STATESVILLE, NC 28677

LOCATION 70 WEST (L) DOVE (R) LEWIS FERRY (L) 3 OAKS (L) HIDDEN OAK, (R) AT #16

SUBDIVISION 3 OAKS BLOCK / SECTION 2 LOT 15 LOT AREA 2.54 SITE CLASS. PS DESIGN FLOW 360 L.T.A.R. .25

REPAIR

Septic Tank: 1000 Gallons; STB 69- Date 6-9-04

Pump Tank: Gallons; PT 1012 Date

Pump Make: Model Serial No.

Nitrification Field: No Fields 1 Square Feet 1440 Linear Feet 480'

No Lines 6x80' Trench Width 36" Max Trench Bottom Depth 18" Gravel Depth 12"

[X] New System [ ] Repair System Type: I, (II), III, IV, V, VI

System Description: CONV 6 LINE ISIDALLOW

Repair System Description: LP DISTRIBUTION

Maintenance Agreement Required: [ ] Yes [X] No

[X] House/Mod. Home No. Bedrooms 3

[ ] Mobile Home No. Bathrooms 2

[ ] Business No. Employees

[ ] Other


[ ] Slab [ ] Crawl Space [ ] Basement w/plumbing [X] Basement wo/plumbing

Water Supply: [ ] Individual [X] Public [ ] Community


Comments/Conditions: (1) SMOOTH OUT CONTOURS UNIFORMLY (2) NOTE MAX TRENCH BOTTOM DEPTH (3) LOTS 15 & 16 COMBINED ON PLAT AS 1 LOT WHICH IS NOW 16

Comments/Conditions: ← 30' FRENCH DRAIN ← INTO BASEMENT DRAIN 79.51

INITIAL SITE SKETCH

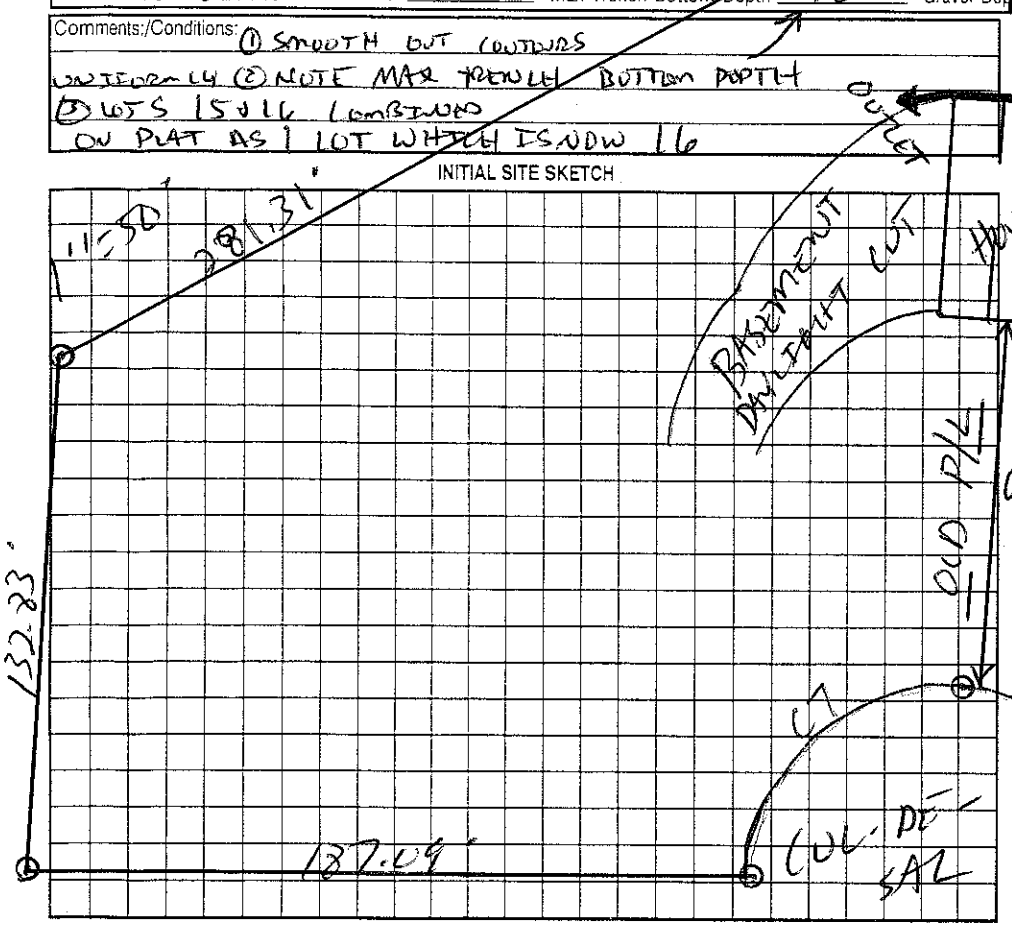

AS BUILT SKETCH

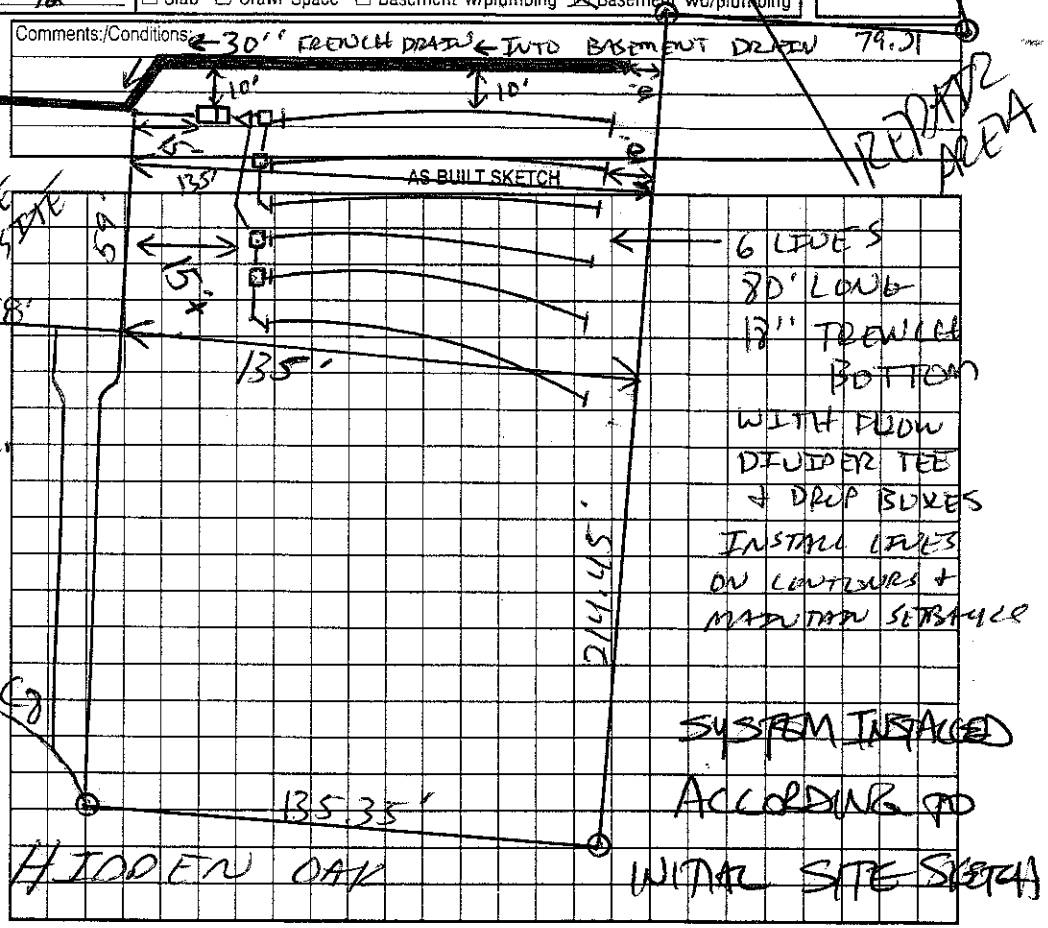

6 LINES
80' LONG
12" TRENCH BOTTOM
WITH FLOW DIVIDER TEE & DROP BOXES
INSTALL LINES ON CONTOURS & MAINTAIN SETBACK

SYSTEM INSTALLED ACCORDING TO INITIAL SITE SKETCH

Permit can be suspended or revoked if any false information is supplied toward securing the permit/any unauthorized changes are made to the site/any unauthorized changes are made in the installation of the system. Improvement Permit with plat valid without expiration. Improvement Permit with site plan valid for sixty months. Authorization to Construct is valid for a period equal to that of Improvement Permit – not to exceed sixty months.

Signed: Kenneth Gadd date 6-4-04 Installed by: DAVID YOUNTZ

Improvement Permit by: [signature] RS date 6-4-04 Operation Permit by: STEVE HENDRICK date 10-25-04

Authorization to Construct by: [signature] RS date 6-4-04 Existing System Inspection by: date

HEALTH DEPT. COPY: WHITE OWNER COPY (FINAL): YELLOW OWNER COPY (INITIAL): PINK