IREDELL COUNTY HEALTH DEPARTMENT

STATESVILLE 704-878-5305 MOORESVILLE 704-664-5281

IMPROVEMENT PERMIT / AUTHORIZATION TO CONSTRUCT / OPERATION PERMIT / EXISTING SYSTEM INSPECTION

PERMIT# 109386 PIN# 4703-84-6386 DATE 10/31/02

OWNER OR CONTRACTOR JERRY PRICE PHONE: Business 704-878-0330 Home

ADDRESS 239 LEWIS FERRY RD. STATESVILLE, NC 28677

LOCATION OLD MOUNTAIN RD, (R) LEWIS FERRY, (R) THREE OAKS, (L) HIDDEN OAKS LN, AROUND CURVE PROPERTY ON RIGHT

SUBDIVISION THREE OAKS BLOCK / SECTION 2 LOT 14 LOT AREA 1.03 ACRES SITE CLASS. PS DESIGN FLOW 360 GPD L.T.A.R. 0.30 GPD/FT²

Septic Tank: 1,000 Gallons; STB 1012 Date 06/10/02
Pump Tank: Gallons; PT Date
Pump Make: Model Serial No.
Nitrification Field: No Fields 1 Square Feet EQ to 1,200 Linear Feet 300
No Lines 5@60' Trench Width 36" Max Trench Bottom Depth 36" Gravel Depth N/A

[X] New System [ ] Repair System Type: I, II, (III), IV, V, VI
System Description: 25% REDUCTION, GRAVITY
Repair System Description: 50% REDUC., LOW PRESSURE
Maintenance Agreement Required: [ ] Yes [X] No


[X] House/Mod. Home No. Bedrooms 3
[ ] Mobile Home No. Bathrooms 2
[ ] Business No. Employees
[ ] Other
[ ] Slab [X] Crawl Space [ ] Basement w/plumbing [ ] Basement wo/plumbing

Water Supply: [ ] Individual [X] Public [ ] Community

Comments/Conditions: (1) GRADE OUT TERRACE (2) DIVERT SURFACE WATER ABOVE SYSTEM (3) MAINTAIN ALL SETBACKS (4) INSTALL LINES ON CONTOUR.

Comments/Conditions: (5) CALL PRIOR TO INSTALLATION FOR REFLAGGING IF NECESSARY.

INITIAL SITE SKETCH

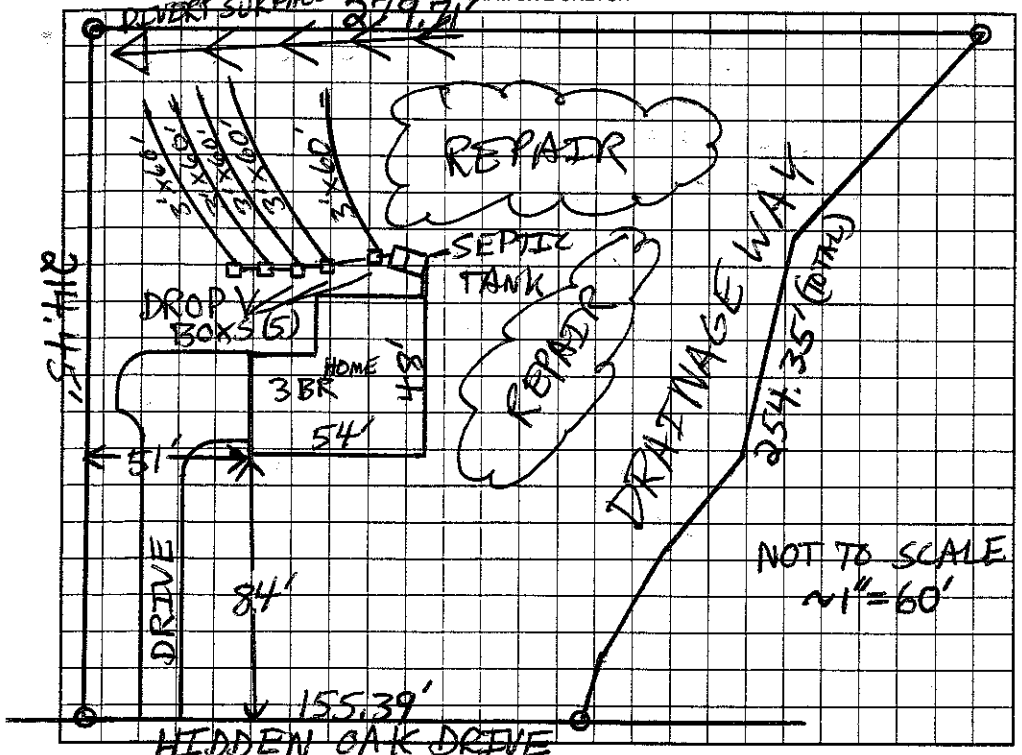

AS BUILT SKETCH

- SEPTIC TANK INSTALLED USING TANK MARKER & TUFF-TIGHT FILTER,

* SYSTEM INSTALLED AS SHOWN IN INITIAL SITE SKETCH.

Permit can be suspended or revoked if any false information is supplied toward securing the permit/any unauthorized changes are made to the site/any unauthorized changes are made in the installation of the system. Improvement Permit with plat valid without expiration. Improvement Permit with site plan valid for sixty months. Authorization to Construct is valid for a period equal to that of Improvement Permit – not to exceed sixty months.

Signed: Jerry W Price date 11-1-02 Installed by: DALE WINGLER

Improvement Permit by: Patrick Mitchell date 10/31/02 Operation Permit by: Patrick Mitchell date 01/15/03

Authorization to Construct by: Patrick Mitchell date 10/31/02 Existing System Inspection by: date

HEALTH DEPT. COPY: WHITE OWNER COPY (FINAL): YELLOW OWNER COPY (INITIAL): PINK