IREDELL COUNTY HEALTH DEPARTMENT

STATESVILLE 704-878-5305 MOORESVILLE 704-664-5281

IMPROVEMENT PERMIT / AUTHORIZATION TO CONSTRUCT / OPERATION PERMIT / EXISTING SYSTEM INSPECTION

PERMIT# 128639 PIN# 4703847677 8767 DATE 7-8-05

OWNER OR CONTRACTOR Jerry Price PHONE: Business 704-878-0330 Home

ADDRESS 23 Lewis Fork Road Statesville 28677

LOCATION Dead End Road (R) Lewis Fork Rd (L) Shed Oak

SUBDIVISION 3 Oak BLOCK / SECTION LOT 6 LOT AREA .85 Acres SITE CLASS PS DESIGN FLOW 360 L.T.A.R. 3

Septic Tank: 1000 Gallons; STB 1012 Date 4/4/05
Pump Tank: Gallons; PT Date
Pump Make: Model Serial No.
Nitrification Field: No Fields Square Feet 1200 Linear Feet 300
No Lines 4 Trench Width 36" Max Trench Bottom Depth 36" Gravel Depth 12"

☐ New System ☐ Repair System Type: I II III IV V VI
System Description: 25% - 6 Equiv
Repair System Description: 25% 6 Equiv
Maintenance Agreement Required: ☐ Yes ☐ No

☐ House/Mod. Home No. Bedrooms 3
☐ Mobile Home No. Bathrooms
☐ Business No. Employees
☐ Other


☐ Slab ☐ Crawl Space ☐ Basement w/plumbing ☐ Basement wo/plumbing

Water Supply: ☐ Individual ☐ Public ☐ Community

Comments:/Conditions: 36" Depth - less than 2%
* Equal Distribution Device (such as Zoeller "Trey-flo")

Comments:/Conditions: ST W/ RISERS AND TUF-X-XP FILTER INSTALLED AS DRAWN WITH A 0-80X AND 48 STANDARD INFILTRATORS

INITIAL SITE SKETCH

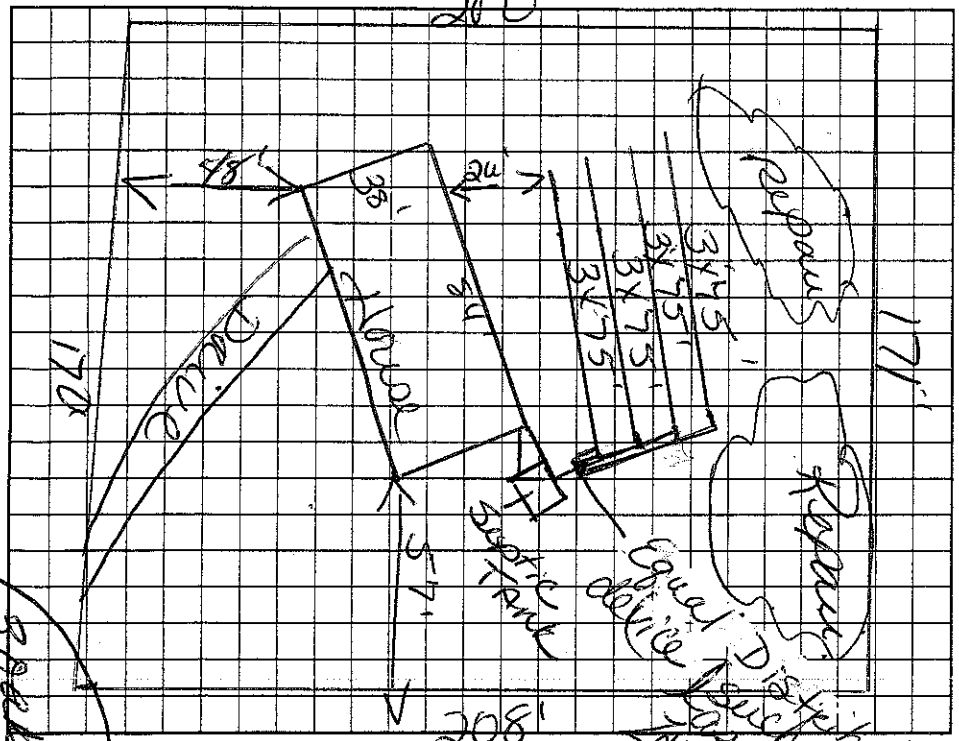

AS BUILT SKETCH

Permit can be suspended or revoked if any false information is supplied toward securing the permit/any unauthorized changes are made to the site/any unauthorized changes are made in the installation of the system. Improvement Permit with plat valid without expiration. Improvement Permit with site plan valid for sixty months. Authorization to Construct is valid for a period equal to that of Improvement Permit – not to exceed sixty months.

Signed: date 7-11-05 Installed by: DALE WINGLER

Improvement Permit by: date 7-8-05 Operation Permit by: date 9/7/05

Authorization to Construct by: date 7-8-05 Existing System Inspection by: date

HEALTH DEPT. COPY: WHITE OWNER COPY (FINAL): YELLOW OWNER COPY (INITIAL): PINK