IREDELL COUNTY HEALTH DEPARTMENT

STATESVILLE 704-878-5305 MOORESVILLE 704-664-5281

IMPROVEMENT PERMIT / CERTIFICATE OF COMPLETION / OPERATION PERMIT / EXISTING SYSTEM INSPECTION

PROPERTY DESCRIPTION NO. 65917 DATE 5-2-97 TAX MAP NO. 4703852536 Watershed: ☐ Yes ☐ No

OWNER OR CONTRACTOR Phillip S. Church PHONE: Business _____ Home 7048812929

ADDRESS 140 Elsie Rd

LOCATION How TL Homan Dr, TR Shady Rest 3rd Drive on left

SUBDIVISION _____ BLOCK / SECTION _____ LOT _____ LOT AREA 3 acres SITE CLASS. PS DESIGN FLOW 360 L.T.A.R. .125

Septic Tank: 1000 Gallons; STB _____ Date 2-21-97

Pump Tank: _____ Gallons; PT _____ Date _____

Pump Make: _____ Model _____ Serial No. _____

Nitrification Field: No Fields 1 Square Feet 1440 Linear Feet 480

No Lines 4 Trench Width 36 Max Trench Bottom Depth 24"

☑ New System ☐ Repair System Type: I, II, III, IV, V, VI

System Description: Conv. Gravity

Repair System Description: ~~Gravity~~ Chamber

Maintenance Agreement Required: ☐ Yes ☐ No

Gravel Depth 12"

☐ House/Mod. Home No. Bedrooms 3

☐ Mobile Home No. Bathrooms 2

☐ Business No. Employees _____

☐ Other _____

☐ Slab ☐ Crawl Space ☐ Basement w/plumbing ☑ Basement wo/plumbing


Water Supply: ☐ Individual ☐ Community ☑ Public

Comments:


200'

Comments:

INITIAL SITE SKETCH

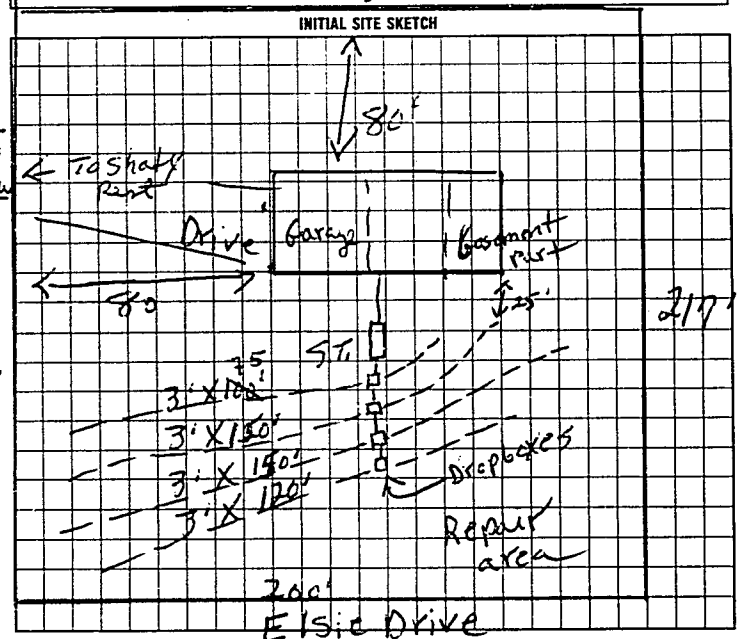

AS BUILT SKETCH

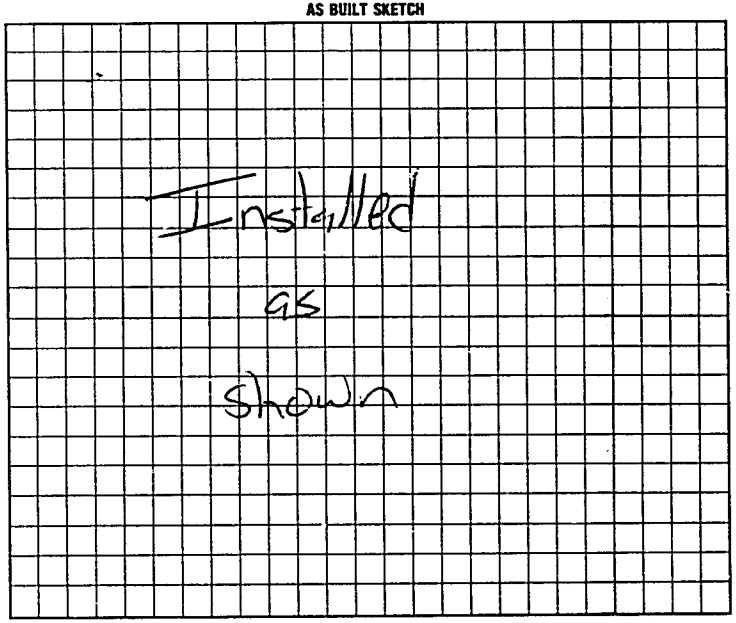

I understand that this permit can be suspended or revoked if any false information is supplied toward securing the permit/any unauthorized changes are made to the site/any unauthorized changes are made in the installation of the system. Improvement Permit is valid for 60 months from date of issuance.

Signed: X Phillip S. Church

Improvement Permit by: L.C. Moore date 5-2-97

~~Existing System Inspection by:~~ L.C. Moore date 5-2-97

Installed by: James Huddler

Certificate of Completion by: _____ date _____

Operation Permit by: Mark C. Ort RS date 5-23-97

HEALTH DEPT. COPY: WHITE INSPECTION COPY (FINAL): GREEN OWNER COPY (FINAL): YELLOW INSPECTION COPY (INITIAL): PINK OWNER COPY (INITIAL): GOLD

to count. authorization to count expires 60 mos from issue

Z 1 0 0 0