IREDELL COUNTY HEALTH DEPARTMENT

STATESVILLE 704-878-5305 MOORESVILLE 704-664-5281

IMPROVEMENT PERMIT / CERTIFICATE OF COMPLETION / OPERATION PERMIT / EXISTING SYSTEM INSPECTION

PROPERTY DESCRIPTION NO. 21034 DATE 6-21-95 TAX MAP NO 8J-A-15.6 Watershed: ☑ Yes ☐ No

OWNER OR CONTRACTOR Gospelway Bapt. Church PHONE: Business Home WJ IV-PA

ADDRESS 179 S. Shady Rest Rd

LOCATION 70W Th Helmann Rd at end TR Shady Rest 1st Property left

SUBDIVISION BLOCK / SECTION LOT LOT AREA 15.26 acres SITE CLASS PS DESIGN FLOW 2100 GPD L.T.A.R. .3

Septic Tank: 3000 Gallons; STB 17 Date 6-7-95

Pump Tank: 3000 Gallons; PT 7 Date 4-8-95

Pump Make: Gould's Model WS2012Q Serial No. F9509792

Nitrification Field: No Fields 1 Square Feet 7200 Linear Feet 2400

No Lines 16 Trench Width 36" Max Trench Bottom Depth 24" Gravel Depth 12"

☑ New System ☐ Repair System Type: I, II, III, IV, V, VI

System Description: Pump To conv. lines

Repair System Description: Pump to LPP

Maintenance Agreement Required: ☐ Yes ☑ No

☐ House/Mod. Home No. Bedrooms

☐ Mobile Home No. Bathrooms

☐ Business No. Employees

☑ Other School 210 students


☐ Slab ☐ Crawl Space ☐ Basement w/plumbing ☐ Basement w/o plumbing

Water Supply: ☐ Individual ☐ Community ☑ Public

Comments: See Attached Sheets for Detail on Following 1. Pump Tank set up. 2. Pressure Manifold set up 3. Drain line Detail. They are part of this permit.

Comments: No Gym with showers & No Cafeteria

INITIAL SITE SKETCH

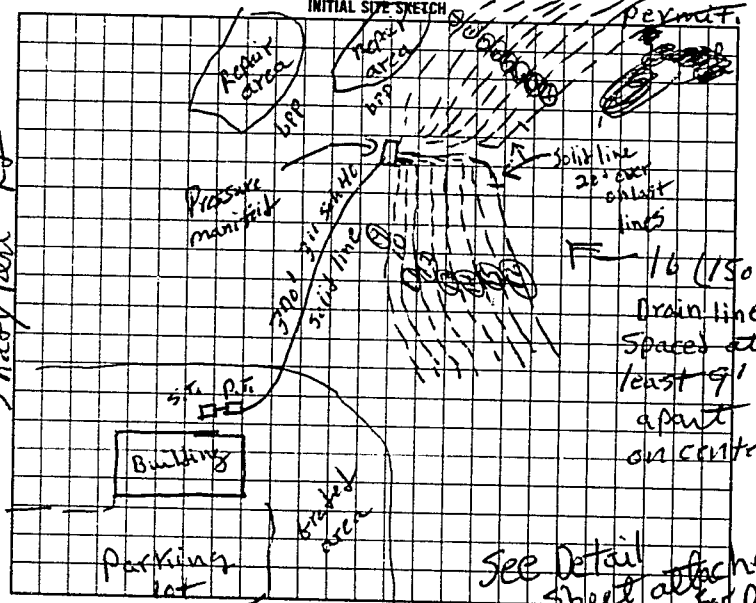

AS BUILT SKETCH

- Inspected drain lines # thru # on 7-18-95
- Inspected tanks on 7-18-95. Did not water test pump tank. Did not get STB # of tank, they were covered up, ask contractor to uncover for next inspection.

11-21-95 Inspected Drain lines 5, 6, 9, 8, 7, 10, 11, 12 RCM

Inspected Drain lines 13, 14, 15, 16

11-24-95 Also Inspected Solid Line from P.T. to manifold RCM

11-29-95 Inspected manifold & Gravity lines to Drain lines RCM

10-24-96 Draw Down & Pump Cycle & Alarm Test

I understand that this permit can be suspended or revoked if any false information is supplied toward securing the permit/any unauthorized changes are made to the site/any unauthorized changes are made in the installation of the system. Improvement Permit is valid for 60 months from date of issuance.

Signed: X William L. Anton

Improvement Permit by: P.C. Moore date 6-21-95

Existing System Inspection by: date

Installed by: James Hutler

Certificate of Completion by: date

Operation Permit by: P.C. Moore date 10-24-97

HEALTH DEPT. COPY: WHITE INSPECTION COPY (FINAL): GREEN OWNER COPY (FINAL): YELLOW INSPECTION COPY (INITIAL): PINK OWNER COPY (INITIAL): GOLD