See permit # 166078 (attached) for garage extension 4/2011.

IREDELL COUNTY HEALTH DEPARTMENT

STATESVILLE 704-878-5305 MOORESVILLE 704-664-5281

IMPROVEMENT PERMIT / AUTHORIZATION TO CONSTRUCT / OPERATION PERMIT / EXISTING SYSTEM INSPECTION

PERMIT# REPAIR PIN# 4703868731 DATE 10-13-05

OWNER OR CONTRACTOR CHUCK PHILBECK PHONE: Business 704-872-6971 Home 704-872-9968

ADDRESS 130 WOODSIDE DR Statesville NC 28677

LOCATION TO WEST, (L) HOLLMAN (R) WOODSIDE (R) AT BOX # 130

SUBDIVISION BLOCK / SECTION LOT 117 LOT AREA SITE CLASS. DESIGN FLOW L.T.A.R. EXISTING

Septic Tank: 1000 Gallons; STB 9-11-05 Date 312
Pump Tank: Gallons; PT Date
Pump Make: Model Serial No.
Nitrification Field: No Fields ✓ Square Feet ✓ Linear Feet ✓
No Lines EXISTING Trench Width ✓ Max Trench Bottom Depth ✓ Gravel Depth ✓

☐ New System ☒ Repair System Type: I (II) III, IV, V, VI
System Description: REPLACE COLLAPSED TANK
Repair System Description:
Maintenance Agreement Required: ☐ Yes ☐ No


☒ House/Mod. Home No. Bedrooms 3
☐ Mobile Home No. Bathrooms 2
☐ Business No. Employees
☐ Other
☐ Slab ☒ Crawl Space ☐ Basement w/plumbing ☐ Basement wo/plumbing

Water Supply: ☐ Individual ☒ Public ☐ Community


Comments:/Conditions: (1) REPLACED TANK WHERE OLD ONE COLLAPSED (2) PUMPED, FILLED & PACKED OLD TANK (3) THIS PERMIT SERVES AS NOTICE OF Violation & MUST BE REPAIRED WITHIN 30 DAYS

Comments:/Conditions: POLY LOK Filter & MARKER

INITIAL SITE SKETCH

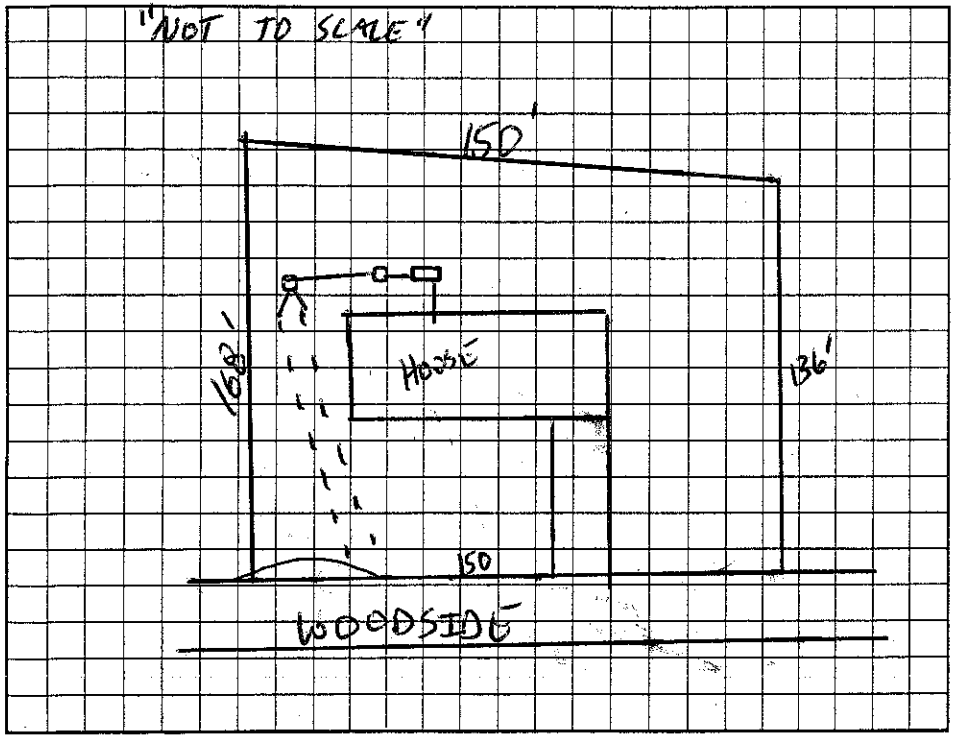

AS BUILT SKETCH

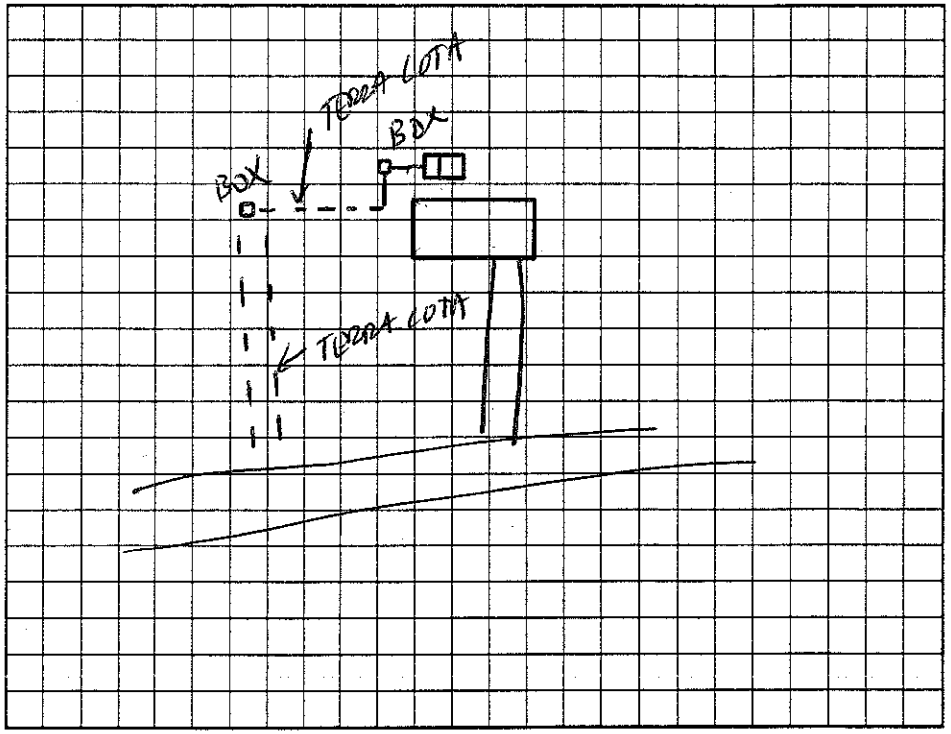

Permit can be suspended or revoked if any false information is supplied toward securing the permit/any unauthorized changes are made to the site/any unauthorized changes are made in the installation of the system. Improvement Permit with plat valid without expiration. Improvement Permit with site plan valid for sixty months. Authorization to Construct is valid for a period equal to that of Improvement Permit – not to exceed sixty months.

Signed: date 10-13-05 Installed by: WES LAYTON

Improvement Permit by: date 10-13-05 Operation Permit by: date 10-14-05

Authorization to Construct by: date 10-13-05 Existing System Inspection by: date

HEALTH DEPT. COPY: WHITE OWNER COPY (FINAL): YELLOW OWNER COPY (INITIAL): PINK