Ray Benfield Authorization to Construct 63402

IREDELL COUNTY HEALTH DEPARTMENT

STATESVILLE 704-878-5305 MOORESVILLE 704-664-5281

IMPROVEMENT PERMIT / ~~CERTIFICATE OF COMPLETION~~ / OPERATION PERMIT / EXISTING SYSTEM INSPECTION

PROPERTY DESCRIPTION NO. 19216 DATE 8/3/96 TAX MAP NO. 8J B 75B Watershed: X Yes ☐ No

OWNER OR CONTRACTOR Glen L. Fitchett Jr - Ray W. Benfield PHONE: Business _____ Home 635-0127

ADDRESS 278 Jewitte Rd. Taylorsville, NC. 28681

LOCATION Pinedell Acres Dr., OMR TR Lewis Ferry TL Pinedell ~.25 mile on (R)

SUBDIVISION Pinedell Acres BLOCK / SECTION _____ LOT N/A LOT AREA ~.5AC SITE CLASS. PS DESIGN FLOW 360 L.T.A.R. .35

Septic Tank: 1000 Gallons; STB 1012 Date 6-24-96 X New System ☐ Repair System Type: I (II) III IV V VI

Pump Tank: _____ Gallons; PT _____ Date _____ System Description: CONV - DROP BOX

Pump Make: _____ Model 1050 Serial No. 350 Repair System Description: IN. PLASTIC

Nitrification Field: No Fields 1 Square Feet ~~1000~~ 1008 Linear Feet ~~385~~ 336 Maintenance Agreement Required: ☐ Yes ☐ No

No Lines #5 Trench Width 36" Max Trench Bottom Depth 32" Gravel Depth 12"

☐ House/Mod. Home No. Bedrooms 3
X Mobile Home No. Bathrooms 2.5
☐ Business No. Employees _____
☐ Other _____


☐ Slab X Crawl Space ☐ Basement w/plumbing ☐ Basement wo/plumbing

Water Supply: ☐ Individual X Community ☐ Public


Comments:

Comments:

INITIAL SITE SKETCH

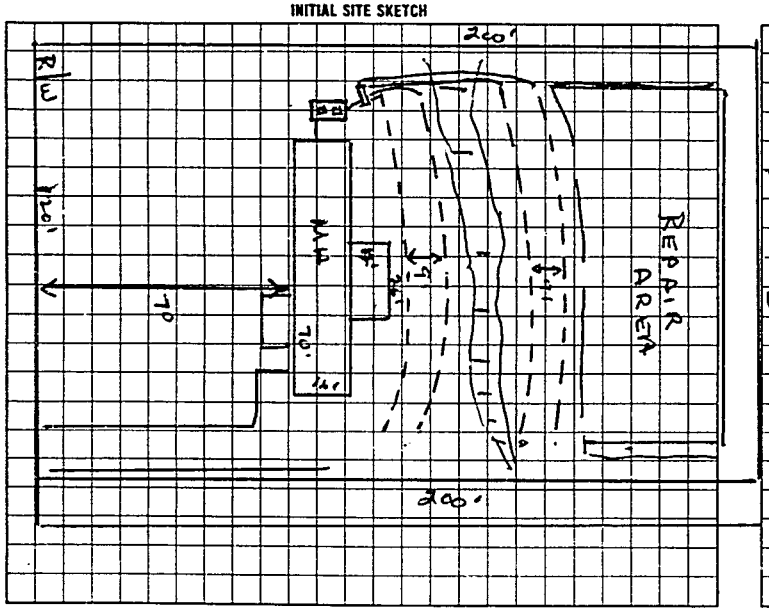

AS BUILT SKETCH

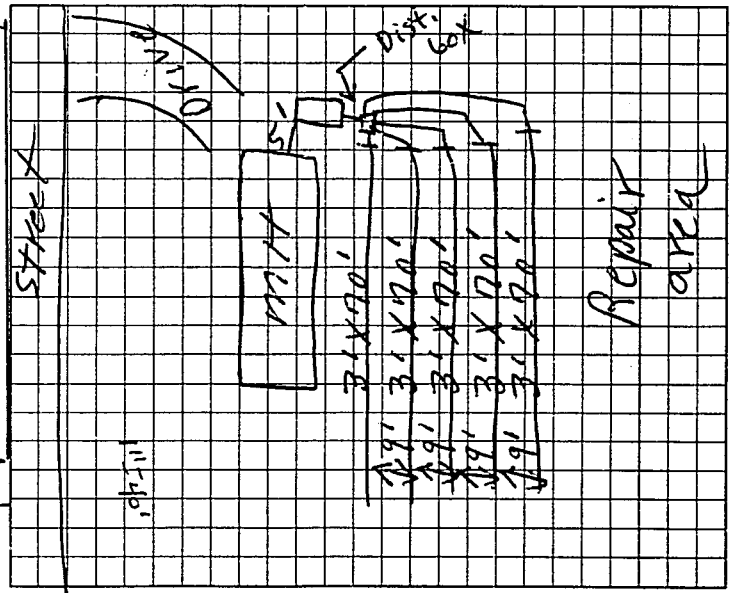

I understand that this permit can be suspended or revoked if any false information is supplied toward securing the permit/any unauthorized changes are made to the site/any unauthorized changes are made in the installation of the system.

Authorization to Construct valid 60 months

Signed: X Alton R. Fox

Improvement Permit by: Wesley Sparks RS. date 8/3/96

Existing System Inspection by: Wesley Sparks RS. date 8/3/96

Installed by: Foust Shuffler

Certificate of Completion by: _____ date _____

Operation Permit by: L.C. Moore date 8-21

HEALTH DEPT COPY: WHITE INSPECTION COPY (FINAL) GREEN OWNER COPY (FINAL) YELLOW INSPECTION COPY (INITIAL) PINK OWNER COPY (INITIAL)

00253