IREDELL COUNTY HEALTH DEPARTMENT

STATESVILLE 704-878-5305 MOORESVILLE 704-664-5281

IMPROVEMENT PERMIT / AUTHORIZATION TO CONSTRUCT / OPERATION PERMIT / EXISTING SYSTEM INSPECTION

PERMIT# 104920 PIN# 4703-91-~~3711-B~~ 1436 DATE 12/23/02

OWNER OR CONTRACTOR JOHN FRAZIER PHONE: Business 704-872-3257 Home 704-871-2469

ADDRESS 269 MORROW FARM RD, STATESVILLE, NC 28677

LOCATION OLD MOUNTAIN RD., (R) LEWIS FERRY, ~1.8 MILES ON LEFT, JUST PAST JARRETT LN. @ END OF DRIVE.

SUBDIVISION — BLOCK / SECTION — LOT — LOT AREA 5.99 ACRES SITE CLASS. PS DESIGN FLOW 480 GPD L.T.A.R. 0.30 GPD/FT²

Septic Tank: 1,000 Gallons; STB 1012 Date 10/04/03
Pump Tank: ____ Gallons; PT ____ Date ____
Pump Make: ____ Model ____ Serial No. 533'
Nitrification Field: No Fields 1 Square Feet ~~1,600~~ Linear Feet ~~800~~
No Lines ~~5080'~~ Trench Width 36" Max Trench Bottom Depth 36"


☒ New System ☐ Repair System Type: I (II) III IV, V, VI
System Description: ~~25% REDUCTION~~, GRAVITY
Repair System Description: 25% REDUCTION, PUMP
Maintenance Agreement Required: ☐ Yes ☒ No
Gravel Depth ~~12"~~ ☐ Slab ☒ Crawl Space ☐ Basement w/plumbing ☐ Basement wo/plumbing

☒ House/Mod. Home No. Bedrooms 4
☐ Mobile Home No. Bathrooms 2
☐ Business No. Employees ____
☐ Other ____

Water Supply: ☐ Individual ☒ Public ☐ Community


Comments:/Conditions:
SIX LINES
GRAVEL DEPTH 12"
* INSTALLED CONVENTIONAL INSTEAD OF 25% REDUC.

INITIAL SITE SKETCH

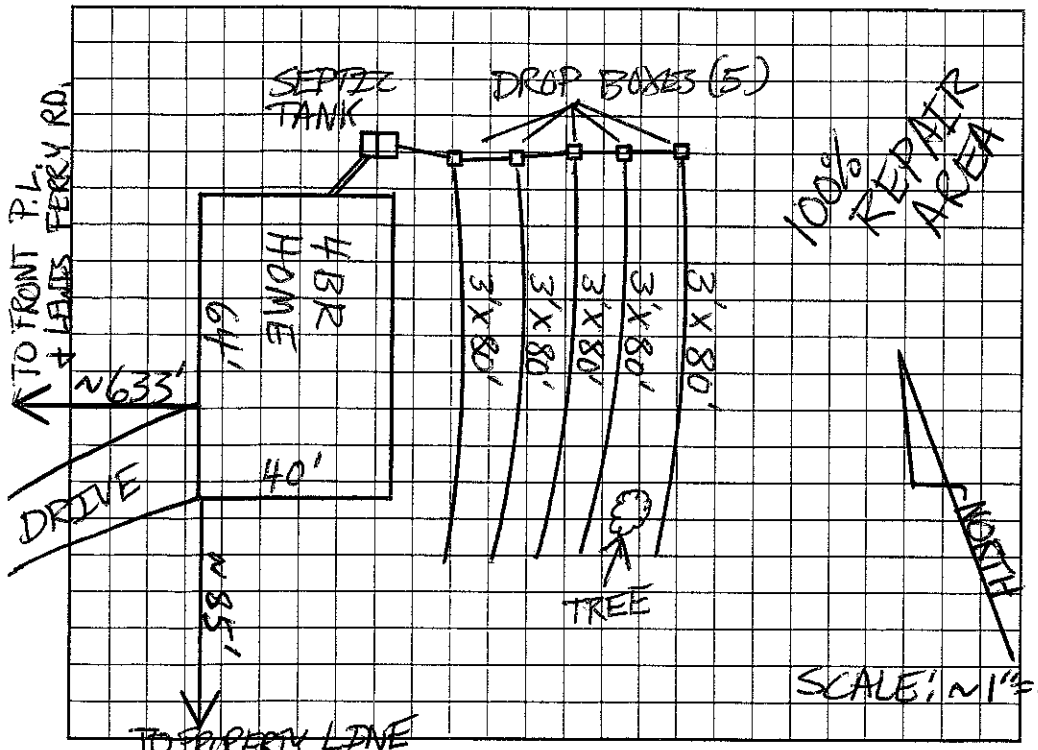

Comments:/Conditions:
- SEPTIC TANK INSTALLED USING TUFF-TIGHT FILTER TANK MARKED
* SYSTEM INSTALLED DURING WET SOIL CONDITIONS *

AS BUILT SKETCH

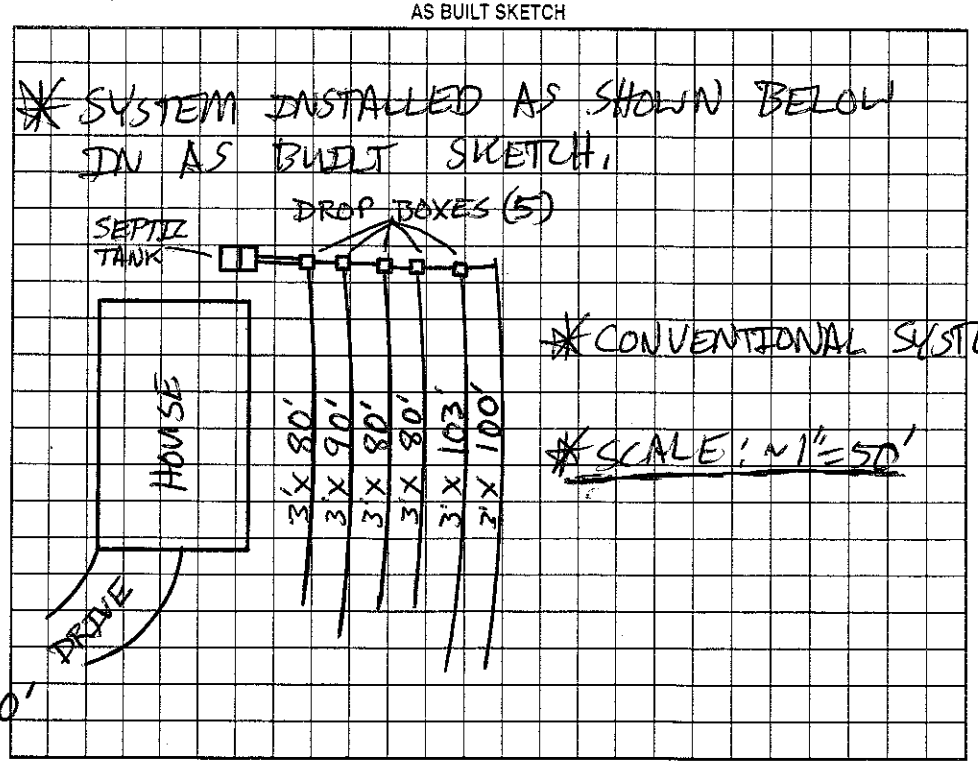

Permit can be suspended or revoked if any false information is supplied toward securing the permit/any unauthorized changes are made to the site/any unauthorized changes are made in the installation of the system. Improvement Permit with plat valid without expiration. Improvement Permit with site plan valid for sixty months. Authorization to Construct is valid for a period equal to that of Improvement Permit – not to exceed sixty months.

Signed: Scott Cushman date 12/30/02 Installed by: FOREST SHUFFORD 03/14/03 & 03/25/03

Improvement Permit by: Patrick Mitchell date 12/23/02 Operation Permit by: Patrick Mitchell date 03/25/03

Authorization to Construct by: Patrick Mitchell date 12/23/02 Existing System Inspection by: ____ date ____

HEALTH DEPT. COPY: WHITE OWNER COPY (FINAL): YELLOW OWNER COPY (INITIAL): PINK