CI

IREDELL COUNTY HEALTH DEPARTMENT

STATESVILLE 704-878-5305 MOORESVILLE 704-664-5281

IMPROVEMENT PERMIT / AUTHORIZATION TO CONSTRUCT / OPERATION PERMIT / EXISTING SYSTEM INSPECTION

DATE 3-11-08

PERMIT# 148677 PIN# 4703929748

OWNER OR APPLICANT K.A. WATT CONST PHONE: Business 704-902-4495 Home

ADDRESS 129 BECKHAM RD STATESVILLE NC 28625

LOCATION BUFFALO SHOALS WEST (R) 6MI (L) LEWIS FERRY ON LEFT @ 369

SUBDIVISION BLOCK / SECTION LOT LOT AREA 5.47 SITE CLASS PS DESIGN FLOW 360 L.T.A.R. 125

Septic Tank: 1000 Gallons; STB 1612 Date 9-24-07

Pump Tank: Gallons; PT Date

Pump Make: Model Serial No.

Nitrification Field: No Fields 1 Square Feet 600=1440 Linear Feet 360

No Lines 5x72' Trench Width 36" Max Trench Bottom Depth 36"

☒ New System ☐ Repair ☐ Expansion System Type: I II (III) IV V VI

System Description: GRAVITY 35% REDUT

Repair System Description: SAME

Maintenance Agreement Required: ☐ Yes ☒ No

Gravel Depth N/A ☒ Gravity ☐ Pressure ☐ Slab ☐ Crawl Space ☒ Basement w/plumbing ☐ Basement wo/plumbing

☒ House/Mod. Home ☐ Mobile Home ☐ Business ☐ Other

No. Bedrooms 3 No. Persons 6 No. Employees


Water Supply: ☐ Individual ☒ Public ☐ Community

Comments/Conditions: (1) SYSTEM SHOT IN ENTIRELY (2) WELL ABANDONMENT FORM IS ATTACHED. (3) SHOOT OUT HUMPS & BUMPS IN AREA FIELD AREA & REMOVE 4" OFF ALL 4 LINES.


Comments/Conditions: ABANDON OLD DRAINFIELD. PUMP/CRUSH/FILL OLD TANK

JUFFTick J. Hes & MAYBE

INITIAL SITE SKETCH

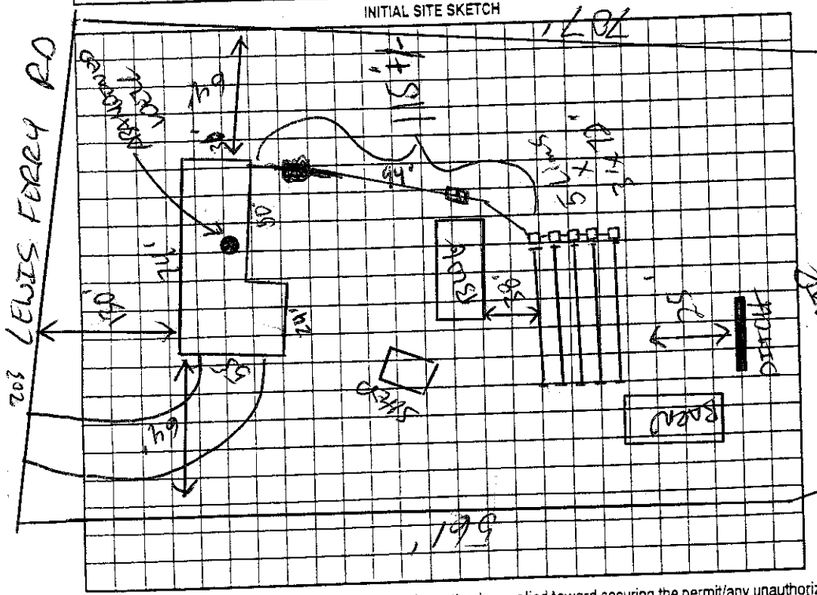

AS BUILT SKETCH

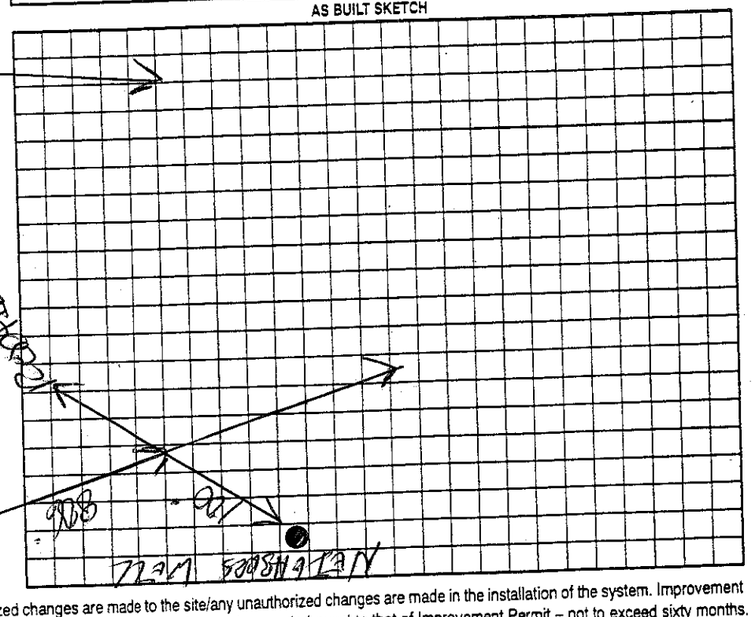

Permit can be suspended or revoked if any false information is supplied toward securing the permit/any unauthorized changes are made to the site/any unauthorized changes are made in the installation of the system. Improvement Permit with site plan valid for sixty months ☒ Permit with plat valid without expiration ☐

Authorization to Construct is valid for a period equal to that of Improvement Permit – not to exceed sixty months.

Signed: Kenneth A Watt date 3-12-08

Improvement Permit by: J. Cole RS date 3-11-08

Authorization to Construct by: J. Cole RS date 3-11-08

Installed by: [redacted] YOUNT GROUP date

Operation Permit by: J. Cole RS date 6-11-08

Existing System Inspection by: date

HEALTH DEPT. COPY: WHITE OWNER COPY (FINAL): YELLOW OWNER COPY (INITIAL): PINK