IREDELL COUNTY HEALTH DEPARTMENT

STATESVILLE 704-878-5305 MOORESVILLE 704-664-5281

4pm

IMPROVEMENT PERMIT / AUTHORIZATION TO CONSTRUCT / OPERATION PERMIT / EXISTING SYSTEM INSPECTION

PERMIT# 88615 PIN# 4703930198 DATE Apr. 18 2000

OWNER OR CONTRACTOR Quail Hollow Bldg Co. PHONE: Business 528-0598 Home

ADDRESS 212 Canal Dr Statesville NC

LOCATION Sth old Mtrd (R) Lewis Ferry (R) Gracelyn (L) Southlynn Hollow To end on Left

SUBDIVISION Three Oaks BLOCK / SECTION III LOT 65 LOT AREA .58 SITE CLASS PS DESIGN FLOW 360 L.T.A.R. .3

Septic Tank: 1000 Gallons; STB 312 Date 7-2-00

Pump Tank: Gallons; PT Date

Pump Make: Model Serial No.

Nitrification Field: No Fields 1 Square Feet 1200 Linear Feet 400

No Lines 4-5 Trench Width 3' Max Trench Bottom Depth 3' Gravel Depth

☐ New System ☐ Repair System Type I (II) III IV V VI

System Description: Conv GRAVITY

Repair System Description: Pump Reduction

Maintenance Agreement Required ☐ Yes ☒ No

☒ House/Mod. Home No. Bedrooms 3

☐ Mobile Home No. Bathrooms 2

☐ Business No. Employees

☐ Other


☐ Slab ☐ Crawl Space ☒ Basement w/plumbing ☐ Basement wo/plumbing

Water Supply: ☐ Individual ☒ Public ☐ Community

Comments/Conditions: INSTALL on CONTOUR
Sch 40 USED FOR ~~FOR DATA~~ DRAIN ↓ Call 928-2030 before you dig
↓ Crossing Septic Field.

Comments/Conditions: SEPTIC TANK WITH MARKER INSTALLED USING "ZABEL" FILTER

INITIAL SITE SKETCH

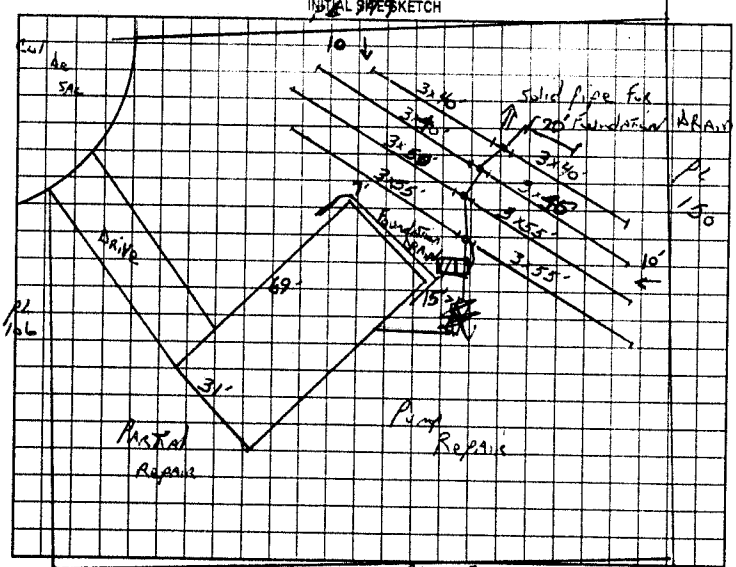

AS BUILT SKETCH

SYSTEM INSTALLED ACCORDING TO INITAL SITE SKETCH

Permit can be suspended or revoked if any false information is supplied toward securing the permit/any unauthorized changes are made to the site/any unauthorized changes are made in the installation of the system. Improvement Permit with plat valid without expiration. Improvement Permit with site plan valid for sixty months. Authorization to Construct is valid for a period equal to that of Improvement Permit – not to exceed sixty months.

Signed: [signature] date 4/19/00 Installed by: CRAIG THOMPSON

Improvement Permit by: [signature] date APR 17 2000 Operation Permit by: STEVE HENDRICK date 8-18-00

Authorization to Construct by: [signature] date April 18, 2000 Existing System Inspection by: date

HEALTH DEPT COPY: WHITE OWNER COPY (FINAL) YELLOW OWNER COPY (INITIAL): PINK