IREDELL COUNTY HEALTH DEPARTMENT

STATESVILLE 704-878-5305 MOORESVILLE 704-664-5281

IMPROVEMENT PERMIT / AUTHORIZATION TO CONSTRUCT / OPERATION PERMIT / EXISTING SYSTEM INSPECTION

PERMIT# 79452 PIN# 4703-93-2397 DATE 3-2-99

OWNER OR CONTRACTOR Randy Myers PHONE: Business 878-0616 Home

ADDRESS 2534 Hickory Hwy Statesville, N.C.

LOCATION Old Mtn Road Turn East Lewis Ferry Rd TR Grace Lynn 3rd lot on Left

SUBDIVISION Three Oaks BLOCK / SECTION LOT 69 LOT AREA .62 acres SITE CLASS PS DESIGN FLOW 360 L.T.A.R. .3

Septic Tank: 1000 Gallons: STB 1012 Date 4-13-99
Pump Tank: Gallons: PT Date
Pump Make: Model Serial No.
Nitrification Field: No Fields 1 Square Feet 1200 Linear Feet 400
No Lines 5 Trench Width 36" Max Trench Bottom Depth 24" Gravel Depth 12"

☑ New System ☐ Repair System Type: I (II) III, IV, V, VI
System Description: Conv. Gravity
Repair System Description: Pump To 25% Red
Maintenance Agreement Required: ☐ Yes ☑ No

☑ House/Mod. Home No. Bedrooms 3
☐ Mobile Home No. Bathrooms 2
☐ Business No. Employees
☐ Other


☐ Slab ☑ Crawl Space ☐ Basement w/plumbing ☐ Basement wo/plumbing

Water Supply: ☐ Individual ☑ Public ☐ Community


Comments/Conditions:

Comments/Conditions:
Note: Tank at back of house ~8 Ft from Corner

INITIAL SITE SKETCH

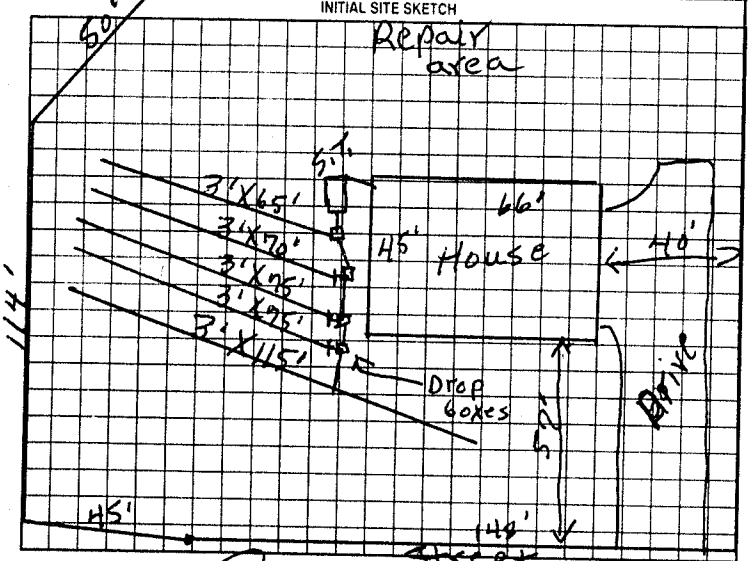

AS BUILT SKETCH

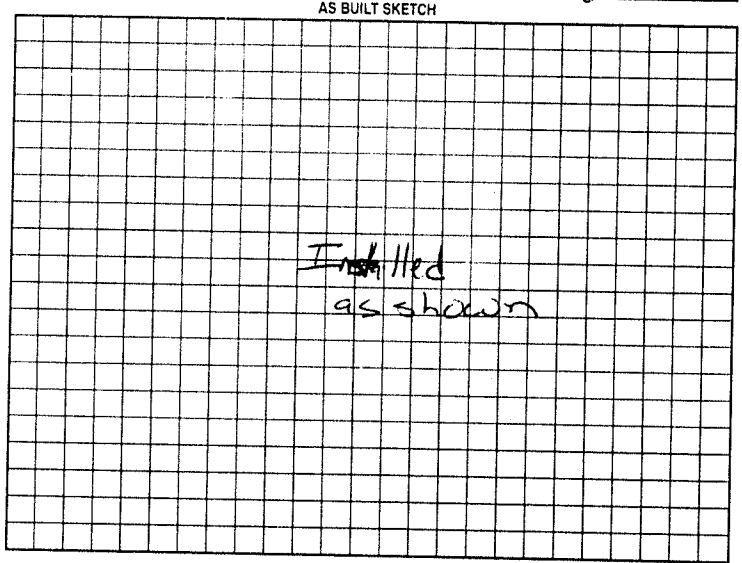

Permit can be suspended or revoked if any false information is supplied toward securing the permit/any unauthorized changes are made to the site/any unauthorized changes are made in the installation of the system. Improvement Permit with plat valid without expiration. Improvement Permit with site plan valid for sixty months. Authorization to Construct is valid for a period equal to that of Improvement Permit – not to exceed sixty months.

Signed: X Randall R. Myers date

Improvement Permit by: J. C. Moore date 3-2-99

Authorization to Construct by: J. C. Moore date 3-2-99

Installed by: Bill Adams

Operation Permit by: Mary C Ott RS date 6-3-99

Existing System Inspection by: date

HEALTH DEPT COPY WHITE OWNER COPY (FINAL) YELLOW OWNER COPY (INITIAL) PINK