IREDELL COUNTY HEALTH DEPARTMENT

STATESVILLE 704-878-5305 MOORESVILLE 704-664-5281

IMPROVEMENT PERMIT / AUTHORIZATION TO CONSTRUCT / OPERATION PERMIT / EXISTING SYSTEM INSPECTION

PERMIT# 109247 PIN# 4703-93-3920 DATE 10/23/02

OWNER OR CONTRACTOR JERRY W. PRICE PHONE: Business 704-878-0330 Home

ADDRESS 239 LEWIS FERRY RD. STATESVILLE, NC 28677

LOCATION HWY 70 W. (L) OLD MOUNTAIN RD, (R) LEWIS FERRY RD., (R) GRACE LYNN, (R) ENGLISH OAK, 2nd LOT ON LEFT.

SUBDIVISION THREE OAKS BLOCK / SECTION 3 LOT 35 LOT AREA 0.92 ACRES SITE CLASS. PS DESIGN FLOW 360 GPD L.T.A.R. 0.30 GPD/FT²

Septic Tank: 1,000 Gallons; STB 1012 Date 08/03/02
Pump Tank: Gallons; PT Date
Pump Make: Model Serial No.
Nitrification Field: No Fields 1 Square Feet EQ to 1,200 Linear Feet 300
No Lines 6 Trench Width 36" Max Trench Bottom Depth 36" Gravel Depth N/A

[X] New System [ ] Repair System Type: I, II, (III), IV, V, VI
System Description: 25% REDUCTION, GRAVITY
Repair System Description: 50% REDUCTION, LOW PRESSURE
Maintenance Agreement Required: [ ] Yes [X] No


[X] House/Mod. Home No. Bedrooms 3
[ ] Mobile Home No. Bathrooms 2
[ ] Business No. Employees
[ ] Other
[ ] Slab [X] Crawl Space [ ] Basement w/plumbing [ ] Basement wo/plumbing

Water Supply: [ ] Individual [X] Public [ ] Community

Comments:/Conditions: (1) CALL AFTER CLEARING, PRIOR TO INSTALLATION FOR REFLAGGING IF NESSEARY. (2) INSTALL LINES ON CONTOUR & MAINTAIN ALL SETBACKS (3) WHERE HOUSE PAD IS CUT, KEEP SYSTEM 15' FROM CUT.

Comments:/Conditions:
- SEPTIC TANK INSTALLED USING TUFF-TIGHT FILTERS & TANK MARKER.

INITIAL SITE SKETCH

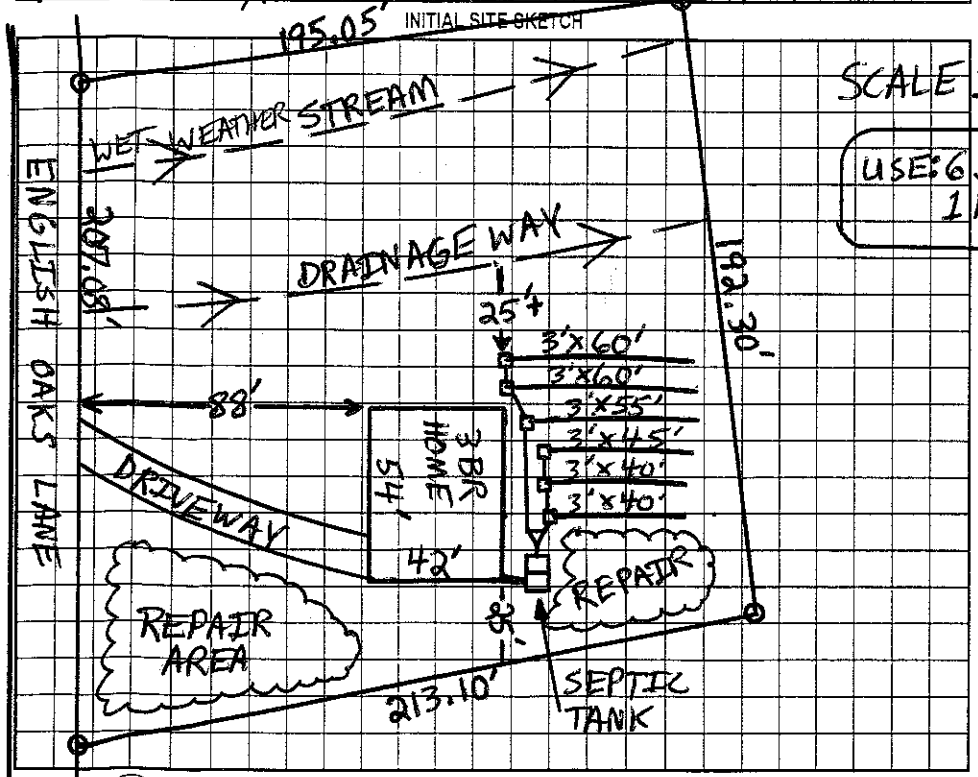

AS BUILT SKETCH

SCALE 1"=60'

USE: 6 DROP BOXS
1 FLOW DIVIDER "T"

X SYSTEM INSTALLED AS SHOWN IN INITIAL SITE SKETCH.

Permit can be suspended or revoked if any false information is supplied toward securing the permit/any unauthorized changes are made to the site/any unauthorized changes are made in the installation of the system. Improvement Permit with plat valid without expiration. Improvement Permit with site plan valid for sixty months. Authorization to Construct is valid for a period equal to that of Improvement Permit – not to exceed sixty months.

Signed: Jerry W Price date 10-23-02 Installed by: DALE WINGLER 03/11/03

Improvement Permit by: Patrick Mitchell date 10/23/02 Operation Permit by: Patrick Mitchell date 03/11/03

Authorization to Construct by: Patrick Mitchell date 10/23/02 Existing System Inspection by: date

HEALTH DEPT. COPY: WHITE OWNER COPY (FINAL): YELLOW OWNER COPY (INITIAL): PINK