IREDELL COUNTY HEALTH DEPARTMENT

STATESVILLE 704-878-5305 MOORESVILLE 704-664-5281

IMPROVEMENT PERMIT / AUTHORIZATION TO CONSTRUCT / OPERATION PERMIT / EXISTING SYSTEM INSPECTION

PERMIT# 73693 PIN# 4703944234 DATE 5-30-98

OWNER OR CONTRACTOR Jerry Price PHONE: Business 8780330 Home

ADDRESS 239 Lewis Ferry Rd Statesville

LOCATION I-40 TL on mtn TR Lewis Ferry TR Grace Lynn TR Englishoak on L

SUBDIVISION Three Oak BLOCK / SECTION LOT 33 LOT AREA .55acres SITE CLASS PS DESIGN FLOW 360 L.T.A.R. .3

Septic Tank: 1000 Gallons; STB 794 Date 7-13-98
Pump Tank: Gallons; PT Date
Pump Make: Model Serial No.
Nitrification Field: No Fields 1 Square Feet 1200 Linear Feet 400
No Lines 4 Trench Width 36" Max Trench Bottom Depth 36" Gravel Depth 24"

☑ New System ☐ Repair System Type: I, II, III, IV, V, VI
System Description: Conv. Gravity
Repair System Description: Pump To Chambers
Maintenance Agreement Required ☐ Yes ☐ No

☑ House/Mod. Home No. Bedrooms 3
☐ Mobile Home No. Bathrooms 2
☐ Business No. Employees
☐ Other


☑ Slab ☑ Crawl Space ☐ Basement w/plumbing ☐ Basement wo/plumbing

Water Supply: ☐ Individual ☑ Public ☐ Community


Comments/Conditions:

Comments/Conditions:
* Note: Slight change in line location per JM

INITIAL SITE SKETCH

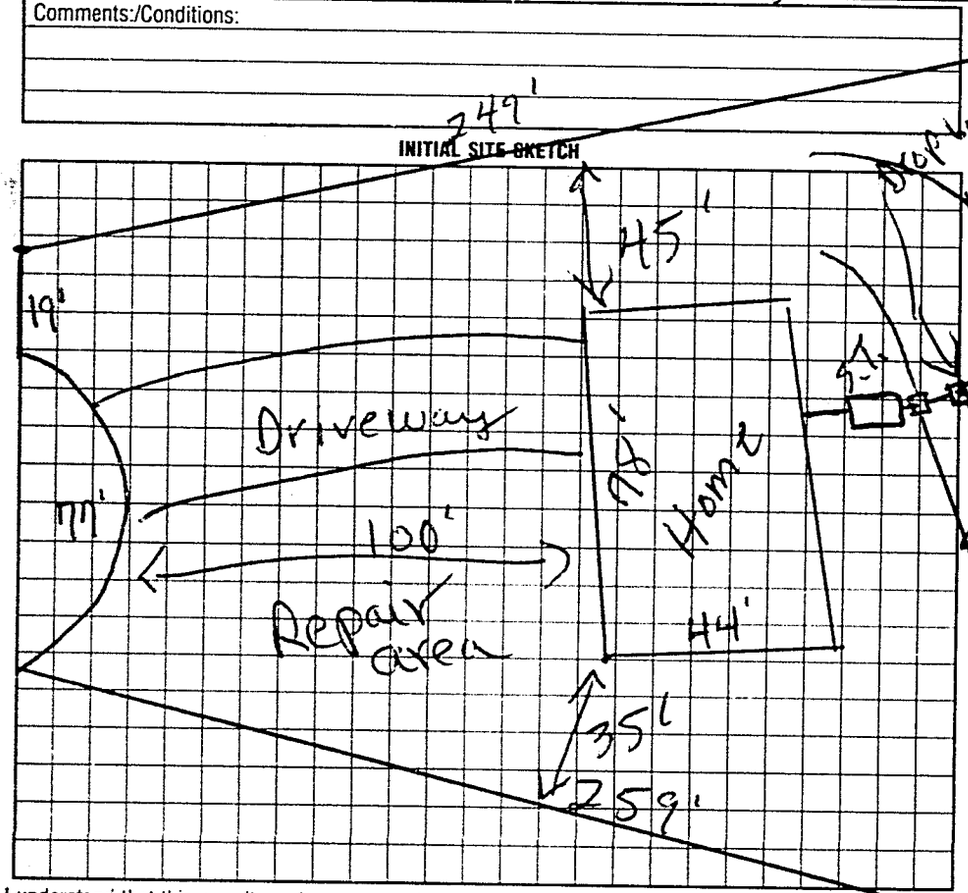

AS BUILT SKETCH

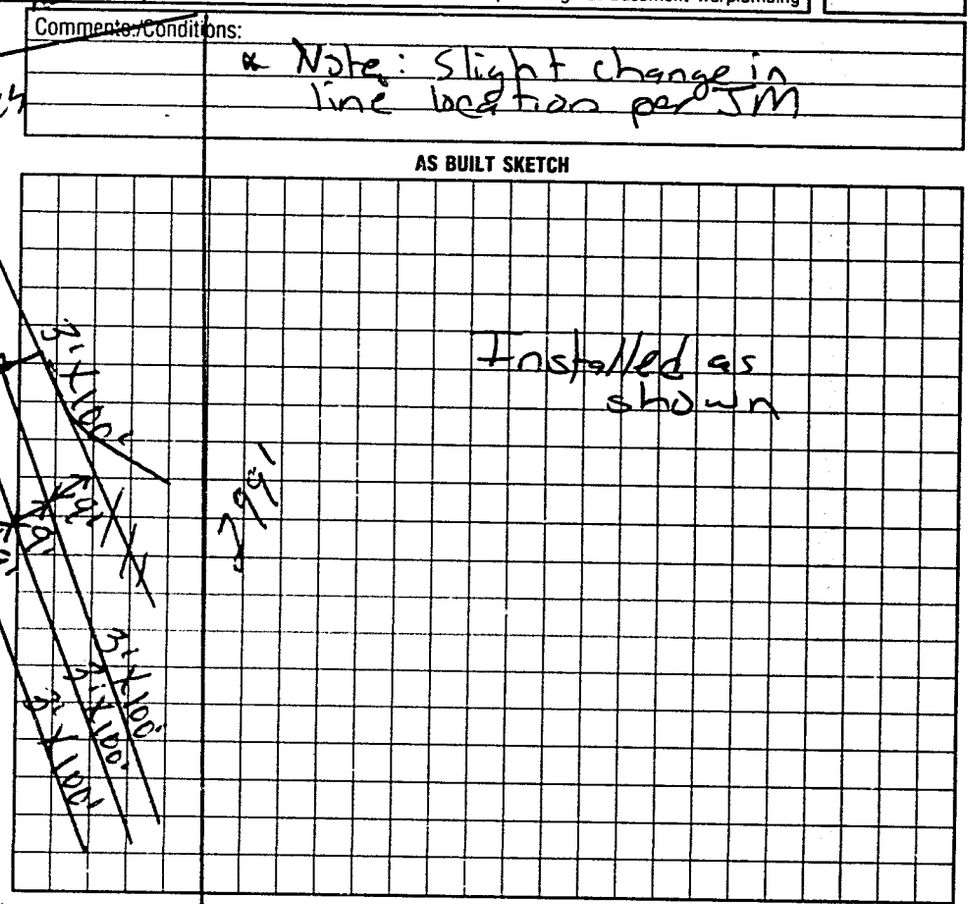

I understand that this permit can be suspended or revoked if any false information is supplied toward securing the permit/any unauthorized changes are made to the site/any unauthorized changes are made in the installation of the system. Improvement Permit with plat valid without expiration. Improvement Permit with site plan valid for sixty months. Authorization to Construct is valid for a period equal to that of Improvement Permit – not to exceed sixty months.

Signed: Jerry W Price date 6-2-98 Installed by: Dale Wingler

Improvement Permit by: J. C. Moore date 5-30-98 Operation Permit by: Mat Cox PS date 9-21-98

Authorization to Construct by: J. C. Moore date 5-30-98 Existing System Inspection by: date

HEALTH DEPT COPY (WHITE) INSPECTION COPY (FINAL) GREEN OWNER COPY (FINAL) YELLOW INSPECTION COPY (INITIAL) PINK OWNER COPY (INITIAL) GOLD

991800