58443

IREDELL COUNTY HEALTH DEPARTMENT

STATESVILLE 704-878-5305 MOORESVILLE 704-664-5281

IMPROVEMENT PERMIT / CERTIFICATE OF COMPLETION / OPERATION PERMIT / EXISTING SYSTEM INSPECTION

PROPERTY DESCRIPTION NO. 22280 DATE 10-23-95 TAX MAP NO. 8J-9-A-2 Watershed: ☐ Yes ☒ No

OWNER OR CONTRACTOR Frank R. Fortner PHONE: Business _____ Home 873-9475 WS4-PA

ADDRESS 134 Warrior Dr. Statesville, NC

LOCATION US 70 TL Old Mtn Rd TR Lewis Ferry Rd TR Three Oaks Lane lot 166

SUBDIVISION Three Oaks BLOCK / SECTION _____ LOT 2 LOT AREA 177X200 SITE CLASS PS DESIGN FLOW 360 L.T.A.R. .3

Septic Tank: 1000 Gallons; STB 1012 Date 3-4-96

Pump Tank: _____ Gallons; PT _____ Date _____

Pump Make: _____ Model _____ Serial No. _____

Nitrification Field: No Fields 4 Square Feet 900 Linear Feet 300

No Lines 4 Trench Width 36" Max Trench Bottom Depth 36" Gravel Depth N/A

☒ New System ☐ Repair System Type: I, II, III, IV, V, VI

System Description: Gravity Chamber Trenches

Repair System Description: _____

Maintenance Agreement Required: ☐ Yes ☐ No


☒ House/Mod. Home ☐ Mobile Home ☐ Business ☐ Other

No. Bedrooms 3 No. Bathrooms 2 No. Employees _____

☐ Slab ☐ Crawl Space ☐ Basement w/plumbing ☒ Basement wo/plumbing

Water Supply: ☐ Individual ☐ Community ☒ Public

Comments:

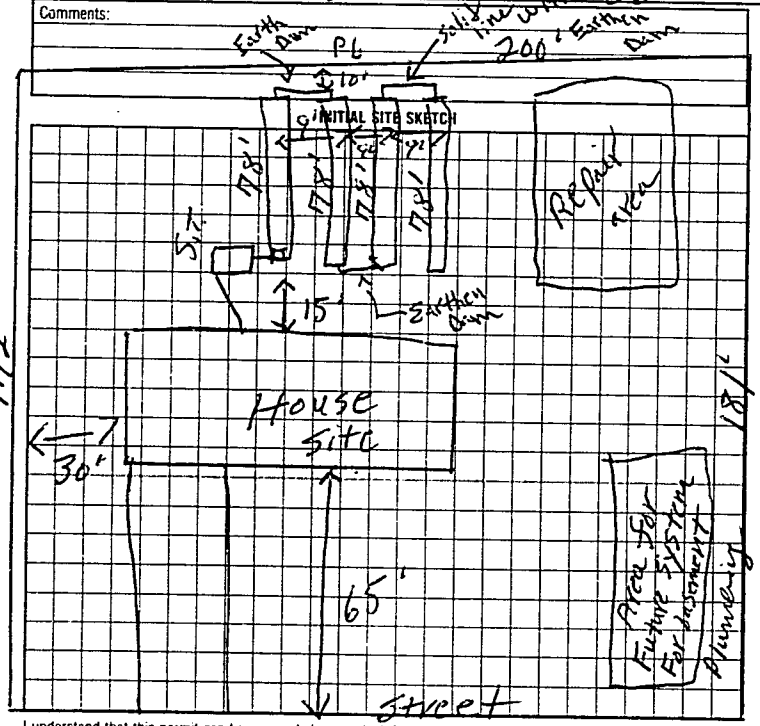

Comments:

AS BUILT SKETCH

Same as initial Sketch

I understand that this permit can be suspended or revoked if any false information is supplied toward securing the permit/any unauthorized changes are made to the site/any unauthorized changes are made in the installation of the system.

Signed: _____

Improvement Permit by: R.C. Moore date 10-23-95

Authorization to Construct Existing System Inspection by: R.C. Moore date _____

Installed by: Tommy Fry/e

Certificate of Completion by: _____ date _____

Operation Permit by: R.C. Moore date 5-13-96

HEALTH DEPT. COPY: WHITE INSPECTION COPY (FINAL): GREEN OWNER COPY (FINAL): YELLOW INSPECTION COPY (INITIAL): PINK OWNER COPY (INITIAL): GOLD

Authorization to Const Expires 60 mos from date of issue

6 1 0 0 0