IREDELL COUNTY HEALTH DEPARTMENT

STATESVILLE 704-878-5305 MOORESVILLE 704-664-5281

IMPROVEMENT PERMIT / AUTHORIZATION TO CONSTRUCT / OPERATION PERMIT / EXISTING SYSTEM INSPECTION

PERMIT# 74812 PIN# 4703-94 7112 DATE 7-8-98

OWNER OR CONTRACTOR Jerry W. Price PHONE: Business 8780330 Home

ADDRESS 239 Lewis Ferry Rd Sta

LOCATION 134 English Oaks E. Lewis Ferry Rd TR Grace Lynn TR English at end RT

SUBDIVISION Three Oaks BLOCK / SECTION LOT 30 LOT AREA 3/4 acre SITE CLASS PS DESIGN FLOW 360 L.T.A.R. .25

Septic Tank: 1000 Gallons; STB 1007 Date 1-18-00
Pump Tank: Gallons; PT Date
Pump Make: Model Serial No.
Nitrification Field: No Fields 1 Square Feet 1080 Linear Feet 360
No Lines 3 Trench Width 36" Max Trench Bottom Depth 36"

☒ New System ☐ Repair System Type: I, II, III, IV, V, VI
System Description: Gravity 1000 gal tank
Repair System Description: LPP
Maintenance Agreement Required: ☐ Yes ☒ No
Gravel Depth N/A

☒ House/Mod. Home ☐ Mobile Home ☐ Business ☐ Other
No. Bedrooms 3 No. Bathrooms 2 No. Employees


☐ Slab ☒ Crawl Space ☐ Basement w/plumbing ☐ Basement wo/plumbing

Water Supply: ☐ Individual ☒ Public ☐ Community


Comments:/Conditions:

Comments:/Conditions: ① SEPTIC TANK W/ MARKER INSTALLED USING "ZABEL" FILTER ② SYSTEM ALTERED AS SHOWN W/ PROR HEALTH DEPT. APPROVAL

INITIAL SITE SKETCH

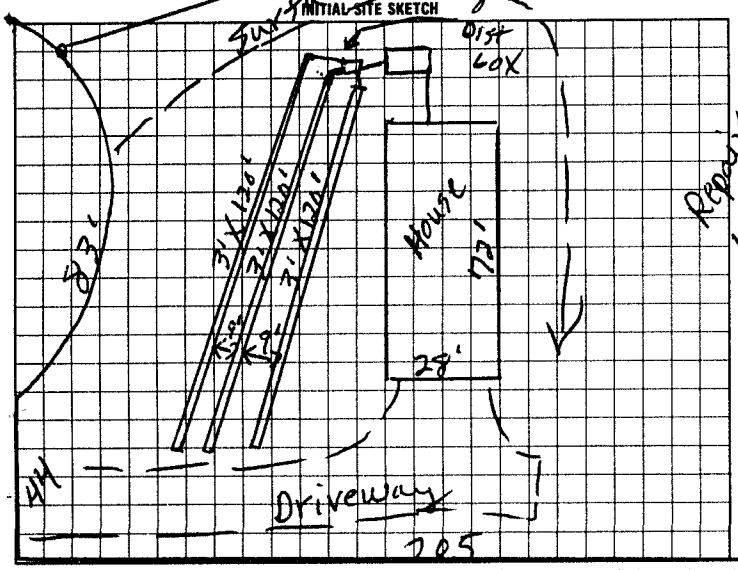

AS BUILT SKETCH

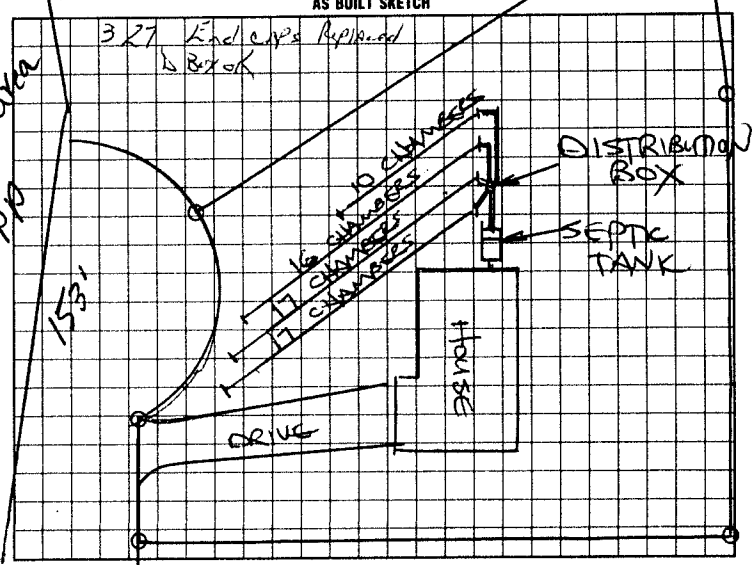

I understand that this permit can be suspended or revoked if any false information is supplied toward securing the permit/any unauthorized changes are made to the site/any unauthorized changes are made in the installation of the system. Improvement Permit with plat valid without expiration. Improvement Permit with site plan valid for sixty months. Authorization to Construct is valid for a period equal to that of Improvement Permit – not to exceed sixty months.

Signed: Jerry Price date 8 10 98 Installed by: J & J BACKHOE

Improvement Permit by: R. C. Moore date 7-8-98 Operation Permit by: C Potts date March 27 2000

Authorization to Construct by: R. C. Moore date 7-8-98 Existing System Inspection by: date

HEALTH DEPT. COPY: WHITE INSPECTION COPY (FINAL): GREEN OWNER COPY (FINAL): YELLOW INSPECTION COPY (INITIAL): PINK OWNER COPY (INITIAL): GOLD