IREDELL COUNTY HEALTH DEPARTMENT

STATESVILLE 704-878-5305 MOORESVILLE 704-664-5281

IMPROVEMENT PERMIT / AUTHORIZATION TO CONSTRUCT / OPERATION PERMIT / EXISTING SYSTEM INSPECTION

PERMIT# 81561 PIN# 4703 94 7268 DATE Dec 7, 99

OWNER OR CONTRACTOR JERRY PRICE PHONE: Business 878-0330 Home

ADDRESS 239 Lewis Ferry Rd STATESVILLE NC

LOCATION Old Mocksville Rd (K) Lewis Ferry (B) Bracelyn (R) English Oak Dr and

SUBDIVISION THREE OAKS BLOCK / SECTION LOT 31 LOT AREA 1.09 SITE CLASS. B3 DESIGN FLOW 360 L.T.A.R. .83

Septic Tank: 1000 Gallons: STB 794 Billings Date 3-18-00

Pump Tank: Gallons: PT Date

Pump Make: Model Serial No.

Nitrification Field: No Fields 1 Square Feet 1200 Linear Feet 400

No Lines 4 Trench Width 36" Max Trench Bottom Depth 36" Gravel Depth 12"

☒ New System ☐ Repair System Type: I (1) III, IV, V, VI

System Description: Conv GRAVITY

Repair System Description: Same Pump Possible

Maintenance Agreement Required: ☐ Yes ☒ No

☒ House/Mod. Home ☐ Mobile Home ☐ Business ☐ Other

No. Bedrooms 3 No. Bathrooms 2 No. Employees


Water Supply: ☐ Individual ☒ Public ☐ Community

☐ Slab ☒ Crawl Space ☐ Basement w/plumbing ☐ Basement wo/plumbing


Comments/Conditions: LANDSCAPE TO PROVIDE DRAINAGE
MAY USE FLOW DIVIDER TEE OR DISTRIBUTION BOX W/ FLOW DIVIDER

Comments/Conditions: ZABEL FILTER USED

INITIAL SITE SKETCH

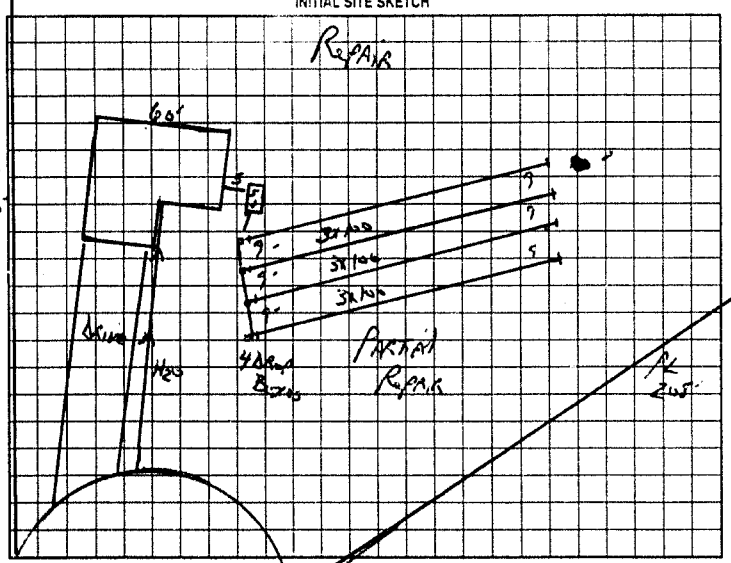

AS BUILT SKETCH

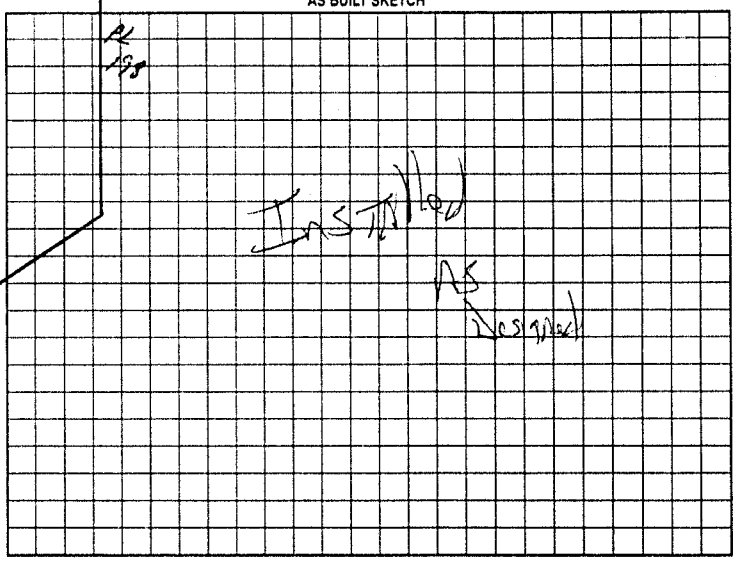

Permit can be suspended or revoked if any false information is supplied toward securing the permit/any unauthorized changes are made to the site/any unauthorized changes are made in the installation of the system. Improvement Permit with plat valid without expiration. Improvement Permit with site plan valid for sixty months. Authorization to Construct is valid for a period equal to that of Improvement Permit – not to exceed sixty months.

Signed: Jerry Price date

Improvement Permit by: J.C Potter date Dec 7 99

Authorization to Construct by: J.C Potter date Dec 7 99

Installed by: Dale Wagler

Operation Permit by: J.C Potter date MAY 1 2000

Existing System Inspection by: date

HEALTH DEPT. COPY: WHITE OWNER COPY (FINAL): YELLOW OWNER COPY (INITIAL): PINK