IREDELL COUNTY HEALTH DEPARTMENT

STATESVILLE 704-878-5305 MOORESVILLE 704-664-5281

IMPROVEMENT PERMIT / AUTHORIZATION TO CONSTRUCT / OPERATION PERMIT / EXISTING SYSTEM INSPECTION

PERMIT# 87980 PIN# 4703948530 DATE March 6 2000

OWNER OR CONTRACTOR Jerry Price PHONE: Business 878-0330 Home

ADDRESS 239 Lewis Ferry Rd Statesville NC

LOCATION Old MTN Rd Sth (R) Ebenis Ferry (R) Three Oaks 2nd on left

SUBDIVISION Three Oaks BLOCK / SECTION LOT 1 LOT AREA .85 SITE CLASS a ~~B~~ B DESIGN FLOW 360 L.T.A.R. .3

Septic Tank: 1000 Gallons; STB 312 Date 4-29-00 ☒ New System ☐ Repair System Type: I II III IV V VI

Pump Tank: Gallons; PT Date System Description: Conv Gravity

Pump Make: Model Serial No. Repair System Description: 25% Possible Grading

Nitrification Field: No Fields 1 Square Feet 1200 Linear Feet 400 Maintenance Agreement Required: ☐ Yes ☒ No

No Lines 3 Trench Width 36" Max Trench Bottom Depth 36" Gravel Depth 12"

☒ House/Mod. Home ☐ Mobile Home ☐ Business ☐ Other

No. Bedrooms 3 No. Bathrooms 2 No. Employees

☐ Slab ☒ Crawl Space ☐ Basement w/plumbing ☐ Basement wo/plumbing


Water Supply: ☐ Individual ☒ Public ☐ Community

Comments/Conditions: Install on Contour
May use Distribution Box w/speed Levels
PL 200


Comments/Conditions:

INITIAL SITE SKETCH

Not To Scale

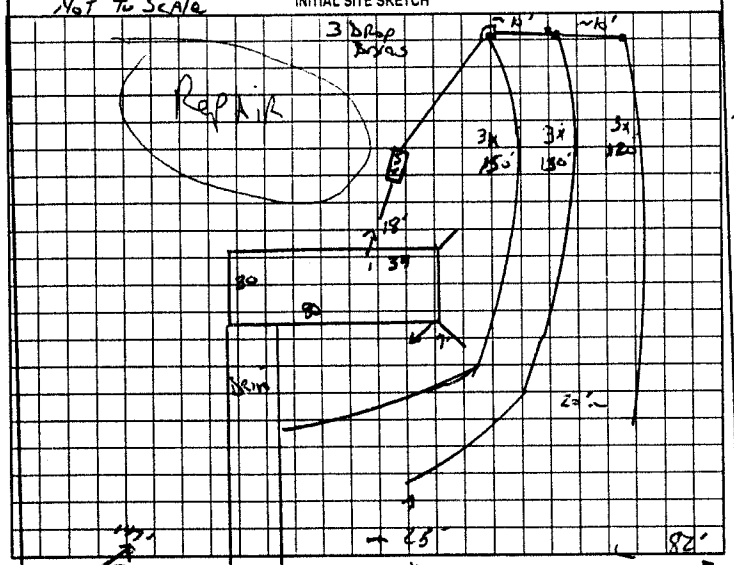

AS BUILT SKETCH

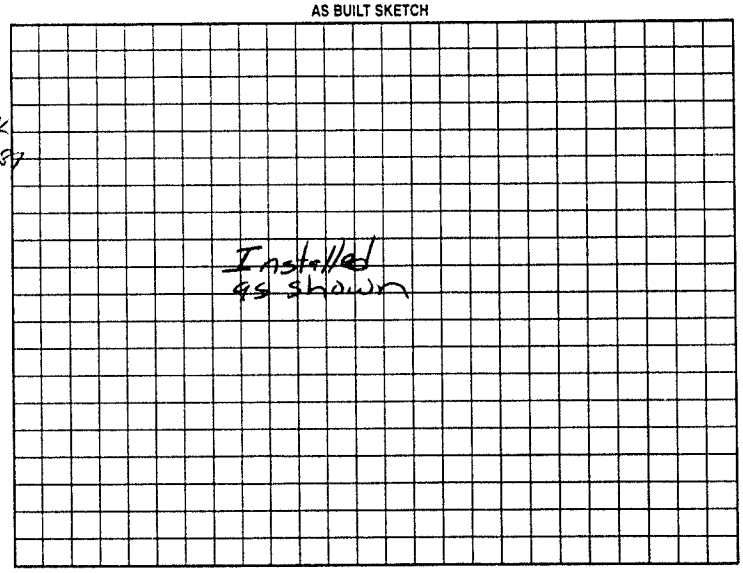

Permit can be suspended or revoked if any false information is supplied toward securing the permit/any unauthorized changes are made to the site/any unauthorized changes are made in the installation of the system. Improvement Permit with plat valid without expiration. Improvement Permit with site plan valid for sixty months. Authorization to Construct is valid for a period equal to that of Improvement Permit – not to exceed sixty months.

Signed: date Installed by: Dale Winakes

Improvement Permit by: L. Potter date March 6 2000 Operation Permit by: Mary C Chitty RS date 6-13-00

Authorization to Construct by: L. Potter date March 6 2000 Existing System Inspection by: date

HEALTH DEPT. COPY: WHITE OWNER COPY (FINAL): YELLOW OWNER COPY (INITIAL): PINK