IREDELL COUNTY HEALTH DEPARTMENT

STATESVILLE 704-878-5305 MOORESVILLE 704-664-5281

IMPROVEMENT PERMIT / CERTIFICATE OF COMPLETION / OPERATION PERMIT / EXISTING SYSTEM INSPECTION

PROPERTY DESCRIPTION NO. 26388 DATE 4-4-97 ~~TAX MAP NO.~~ PIN NO. 4763-95-2706 Watershed: ☑ Yes ☐ No

OWNER OR CONTRACTOR Gospelway Baptist Church PHONE: Business _____ Home _____

ADDRESS ~~19~~ Shady Rest Trl

LOCATION 70 W & TL Holman Rd at end TR Shady Rest 2nd lot left

SUBDIVISION _____ BLOCK / SECTION _____ LOT 100 X 200 LOT AREA .5 acre SITE CLASS. _____ DESIGN FLOW 360 L.T.A.R. .132

Septic Tank: 1000 Gallons; STB 1067 Date 3-4-97

Pump Tank: _____ Gallons; PT _____ Date _____

Pump Make: _____ Model _____ Serial No. _____

Nitrification Field: No Fields 1 Square Feet 846 Linear Feet 282

No Lines 4 Trench Width 36" Max Trench Bottom Depth 36" Gravel Depth N/A

☑ New System ☐ Repair System Type: I, II, III, IV, V, VI

System Description: Cranunity Chambers

Repair System Description: Pump to Chambers

Maintenance Agreement Required: ☑ Yes ☐ No

☐ House/Mod. Home ☐ Mobile Home ☐ Business ☐ Other

No. Bedrooms 3 No. Bathrooms 2 No. Employees ___


☐ Slab ☑ Crawl Space ☐ Basement w/plumbing ☐ Basement wo/plumbing

Water Supply: ☐ Individual ☑ Community ☐ Public


Comments:

Comments:

INITIAL SITE SKETCH

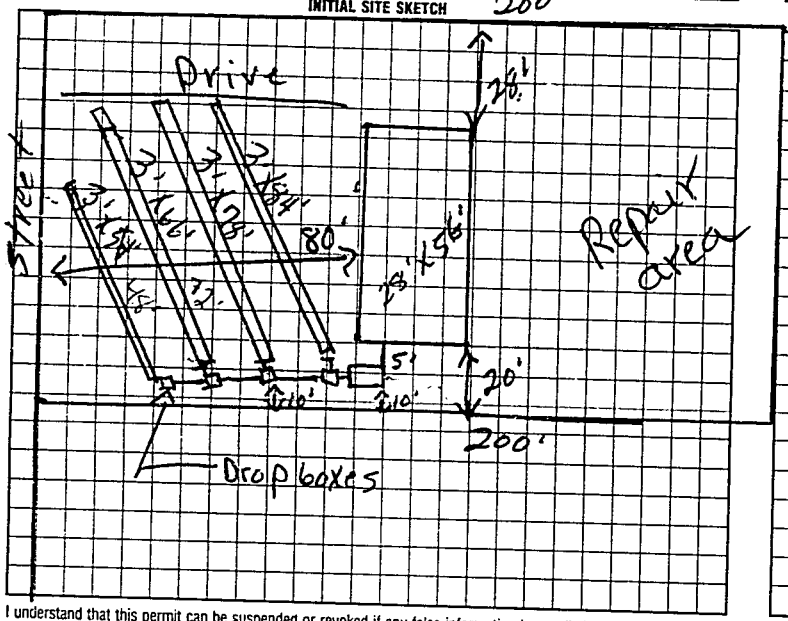

AS BUILT SKETCH

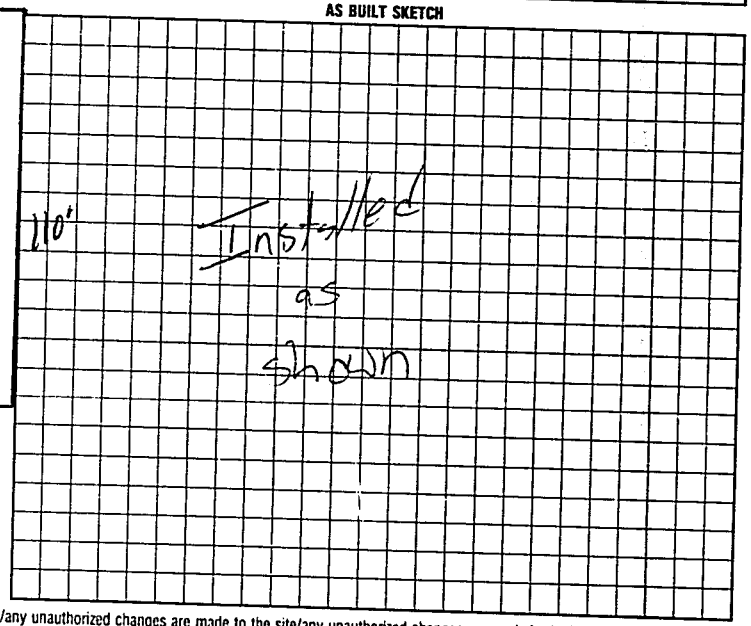

I understand that this permit can be suspended or revoked if any false information is supplied toward securing the permit/any unauthorized changes are made to the site/any unauthorized changes are made in the installation of the system. Improvement Permit is valid for 60 months from date of issuance.

Signed: X Bill Hunter

Improvement Permit by: R. C. Moore date 4-4-97

Existing System Inspection by: R. C. Moore date 4-4-97

Authorization to court

Installed by: James Hudler

Certificate of Completion by: _____ date _____

Operation Permit by _____ date 4-15-97

HEALTH DEPT COPY: WHITE INSPECTION COPY (FINAL): GREEN OWNER COPY (FINAL): YELLOW INSPECTION COPY (INITIAL): PINK OWNER COPY (INITIAL): GOLD

Authorization to court EXPIRES 60 mos from issue.

25000