IREDELL COUNTY HEALTH DEPARTMENT

Statesville Phone TR 3-7271 Mooresville Phone NO 3-1271

PERMIT TO INSTALL SEPTIC TANK

Permit No. 389 Permit Date Nov 12 1970

Owner Hope Bros Builders Inc Address Statesville, NC.

Installed By Adams Septic Tank Service Address Taylorsville, NC


Location of Property West on Highway 70, Past White Oak Turn Left at Shiloh Acres. Go to End of Road, Turn Right. 2nd House on Right.

Tank		Capacity		Length of Lines		Fixtures	
Block	( )	1000	(✓)	225'	(✓)	No. of Baths	(1)
Precast	(✓)	1250	( )	250'	( )	Dishwasher	( )
		1500	( )	Other		Garbage Grdr.	( )
		Other				Other	

NOTIFY HEALTH DEPARTMENT AT LEAST EIGHT HOURS BEFORE TANK IS TO BE INSPECTED.

Final Inspection Nov. 12 1970 Approved (✓) Disapproved ( )

Remarks

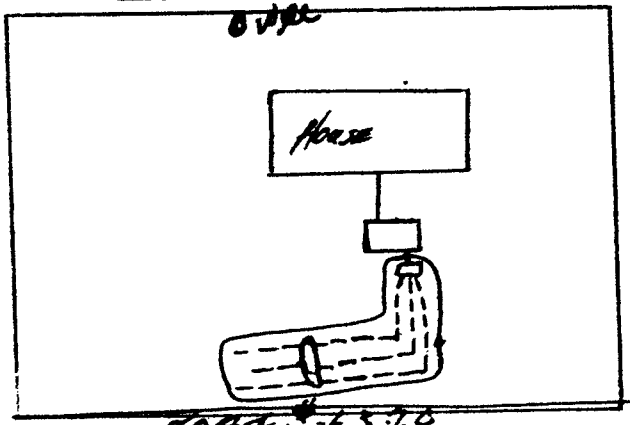

Sketch of Installation

Sanitarian