IREDELL COUNTY HEALTH DEPARTMENT

STATESVILLE 704-878-5305 MOORESVILLE 704-664-5281

IMPROVEMENT PERMIT / CERTIFICATE OF COMPLETION / OPERATION PERMIT / EXISTING SYSTEM INSPECTION

PROPERTY DESCRIPTION NO. Repair DATE 8-23-93 TAX MAP NO. Repair

OWNER OR CONTRACTOR Allen Josey PHONE: Business Home

ADDRESS

LOCATION I40W TL old Mtn. Rd. TR 70W TL Holman Rd. Lot on R in corner of Holman Rd and Woodside Lane

SUBDIVISION NA BLOCK / SECTION LOT LOT AREA SITE CLASS. P.S. L.T.A.R. Existing

Water Supply: ☐ Individual ☐ Community ☑ Public

Septic Tank: 1000 Gallons; STB 794 Date 7-21-93

Pump Tank: — Gallons; PT — Date —

Nitrification Field: No Fields 2 Square Feet 900 Linear Feet 300'

No Lines 3 Trench Width 36" Trench Depth 18"-36" Gravel Depth 12"

☐ New System ☑ Repair System Type: I (II) II, IV, V, VI

System Description: conventional, gravity

Repair System Description: " "

Maintenance Agreement Required: ☐ Yes ☑ No

☑ House/Mod. Hor No. Bedrooms 3

☐ Mobile Home No. Bathrooms 1.5

☐ Business No. Employees —

☐ Other

Garbage Disposal: ☐ Yes ☑ No

Auto. Dishwasher: ☐ Yes ☑ No


Auto. Washing Machine: ☑ Yes ☐ No

Other


☐ Slab ☑ Crawl Space ☐ Basement w/plumbing ☐ Basement wo/plumbing

Comments Reroute plumbing to front yard. Leave washing machine and kitchen sink on old system. Keep system as shallow as possible, add cover over tank if needed. Keep system 5' from foundation of home. This permit voids permit issued 6-9-93.

INITIAL SITE SKETCH

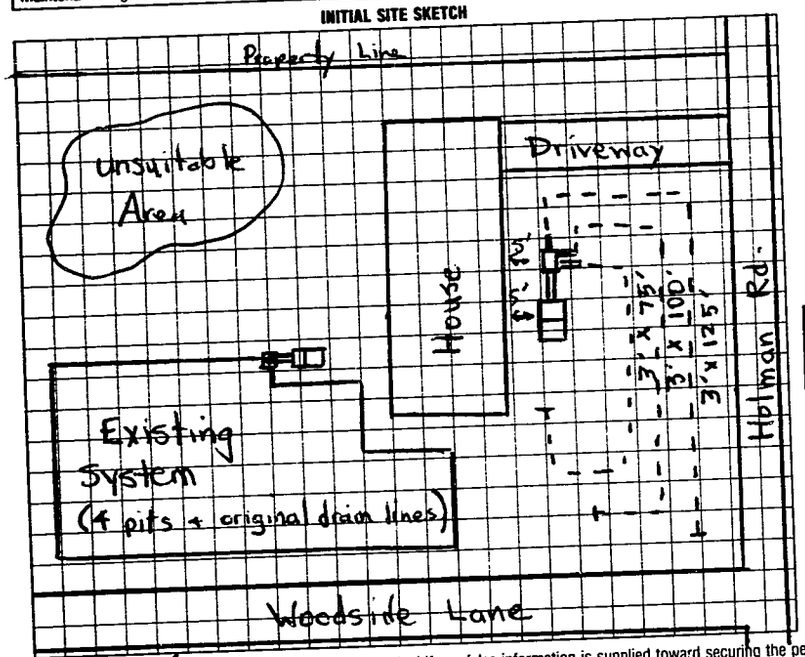

AS BUILT SKETCH

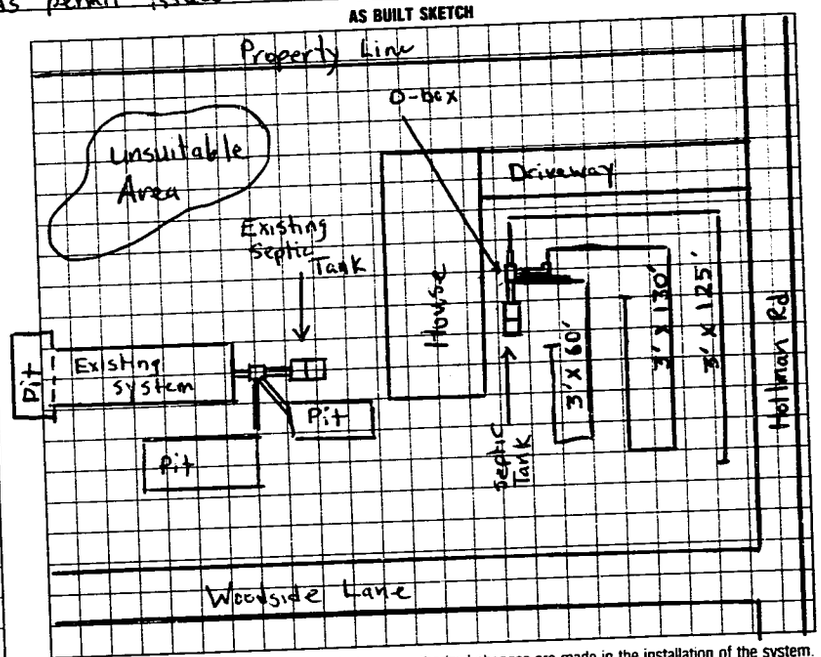

I understand that this permit can be suspended or revoked if any false information is supplied toward securing the permit/any unauthorized changes are made to the site/any unauthorized changes are made in the installation of the system. Improvement Permit is valid for 60 months from date of issuance.

Signed: Allen Josey

Improvement Permit by: Michael J. Dennis / D.C. moore date 8-23-93

Existing System Inspection by: date

Installed by: Wes Lytton

Certificate of Completion by: Michael J. Dennis date 9-1-93

Operation Permit by: date

HEALTH DEPT. COPY: WHITE INSPECTION COPY (FINAL): GREEN OWNER COPY (FINAL): YELLOW INSPECTION COPY (INITIAL): PINK OWNER COPY (INITIAL) GOLD