IREDELL COUNTY HEALTH DEPARTMENT

Statesville Phone TR 3-7271 Mooresville Phone NO 3-1271

PERMIT TO INSTALL SEPTIC TANK

Permit No. _____ Permit Date 12-31-1964

Owner WOOTEN & DELINGER Address _____

Installed By SMITH SEPTIC Address _____


Location of Property ON OLD #20 W. PASS WHITE OAK 1st NEW DEVELOPMENT ON LEFT ½ MILE IN & ON RIGHT

Tank		Capacity		Length of Lines		Fixtures	
Block	( )	1000	(✓)	225'	(✓)	No. of Baths	(✓)
Precast	(✓)	1250	( )	250'	( )	Dishwasher	(✓)
		1500	( )	Other _____		Garbage Grdr.	( )
		Other _____				Other _____	

NOTIFY HEALTH DEPARTMENT AT LEAST EIGHT HOURS BEFORE TANK IS TO BE INSPECTED.

Final Inspection 12 31 1964 Approved (✓) Disapproved ( )

Remarks _____

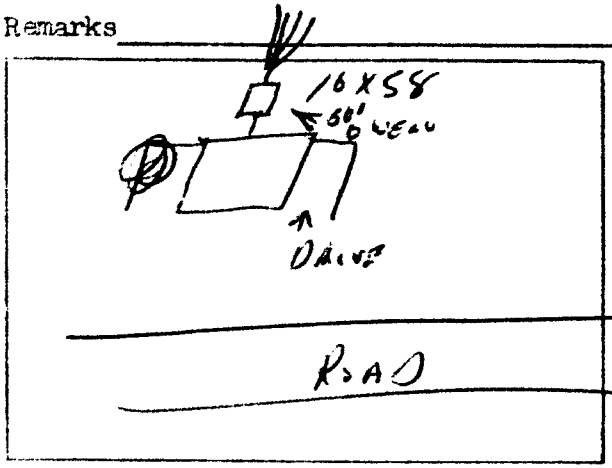

Sketch of Installation.

Sanitarian