IREDELL COUNTY HEALTH DEPARTMENT

STATESVILLE 704-878-5305 CI-Notice MOORESVILLE 704-664-5281

IMPROVEMENT PERMIT / AUTHORIZATION TO CONSTRUCT / OPERATION PERMIT / EXISTING SYSTEM INSPECTION

PERMIT# ~~HS 88~~ 116444 PIN# 4703-96-7054 DATE 10/3/03

OWNER OR CONTRACTOR Michael Estes PHONE: Business — Home (704) 873-0839

ADDRESS 1759 Old Mtn Rd Statesville NC 28677

LOCATION I-40 W, (L) Old Mtn Rd (R) Lewis Ferry (R) Shady Rest 3rd lt on left

SUBDIVISION — BLOCK / SECTION ____ LOT ____ LOT AREA ± .815 Ac SITE CLASS. PS DESIGN FLOW 360 L.T.A.R. .25 gpd/ft²

Septic Tank: 1000 Gallons; STB 1007 Date 8-18-03
Pump Tank: ____ Gallons; PT ____ Date ____
Pump Make: ____ Model ____ Serial No. ____
Nitrification Field: No Fields 1 Square Feet Equiv 1440 Linear Feet 360
No Lines ____ Trench Width 36" Max Trench Bottom Depth 32" Gravel Depth N/A

☒ New System ☐ Repair System Type: I, II, (III), IV, V, VI
System Description: Gravity, 25% Reduction
Repair System Description: Pump, 25% Reduction
Maintenance Agreement Required: ☐ Yes ☒ No
☐ Slab ☒ Crawl Space ☐ Basement w/plumbing ☐ Basement wo/plumbing


☐ House/Mod. Home ☒ Mobile Home ☐ Business ☐ Other ____
No. Bedrooms 3 No. Bathrooms 2 No. Employees ____

Water Supply: ☐ Individual ☐ Public ☐ Community


Comments:/Conditions: (1) Fill + Crush Old Tank (2) Install liner or contour

Comments:/Conditions:
- Tuff Tite Filter + ST Marker Installed
- 360 ft ~~[illegible]~~ EZ Flow ~~[illegible]~~ Installed

INITIAL SITE SKETCH

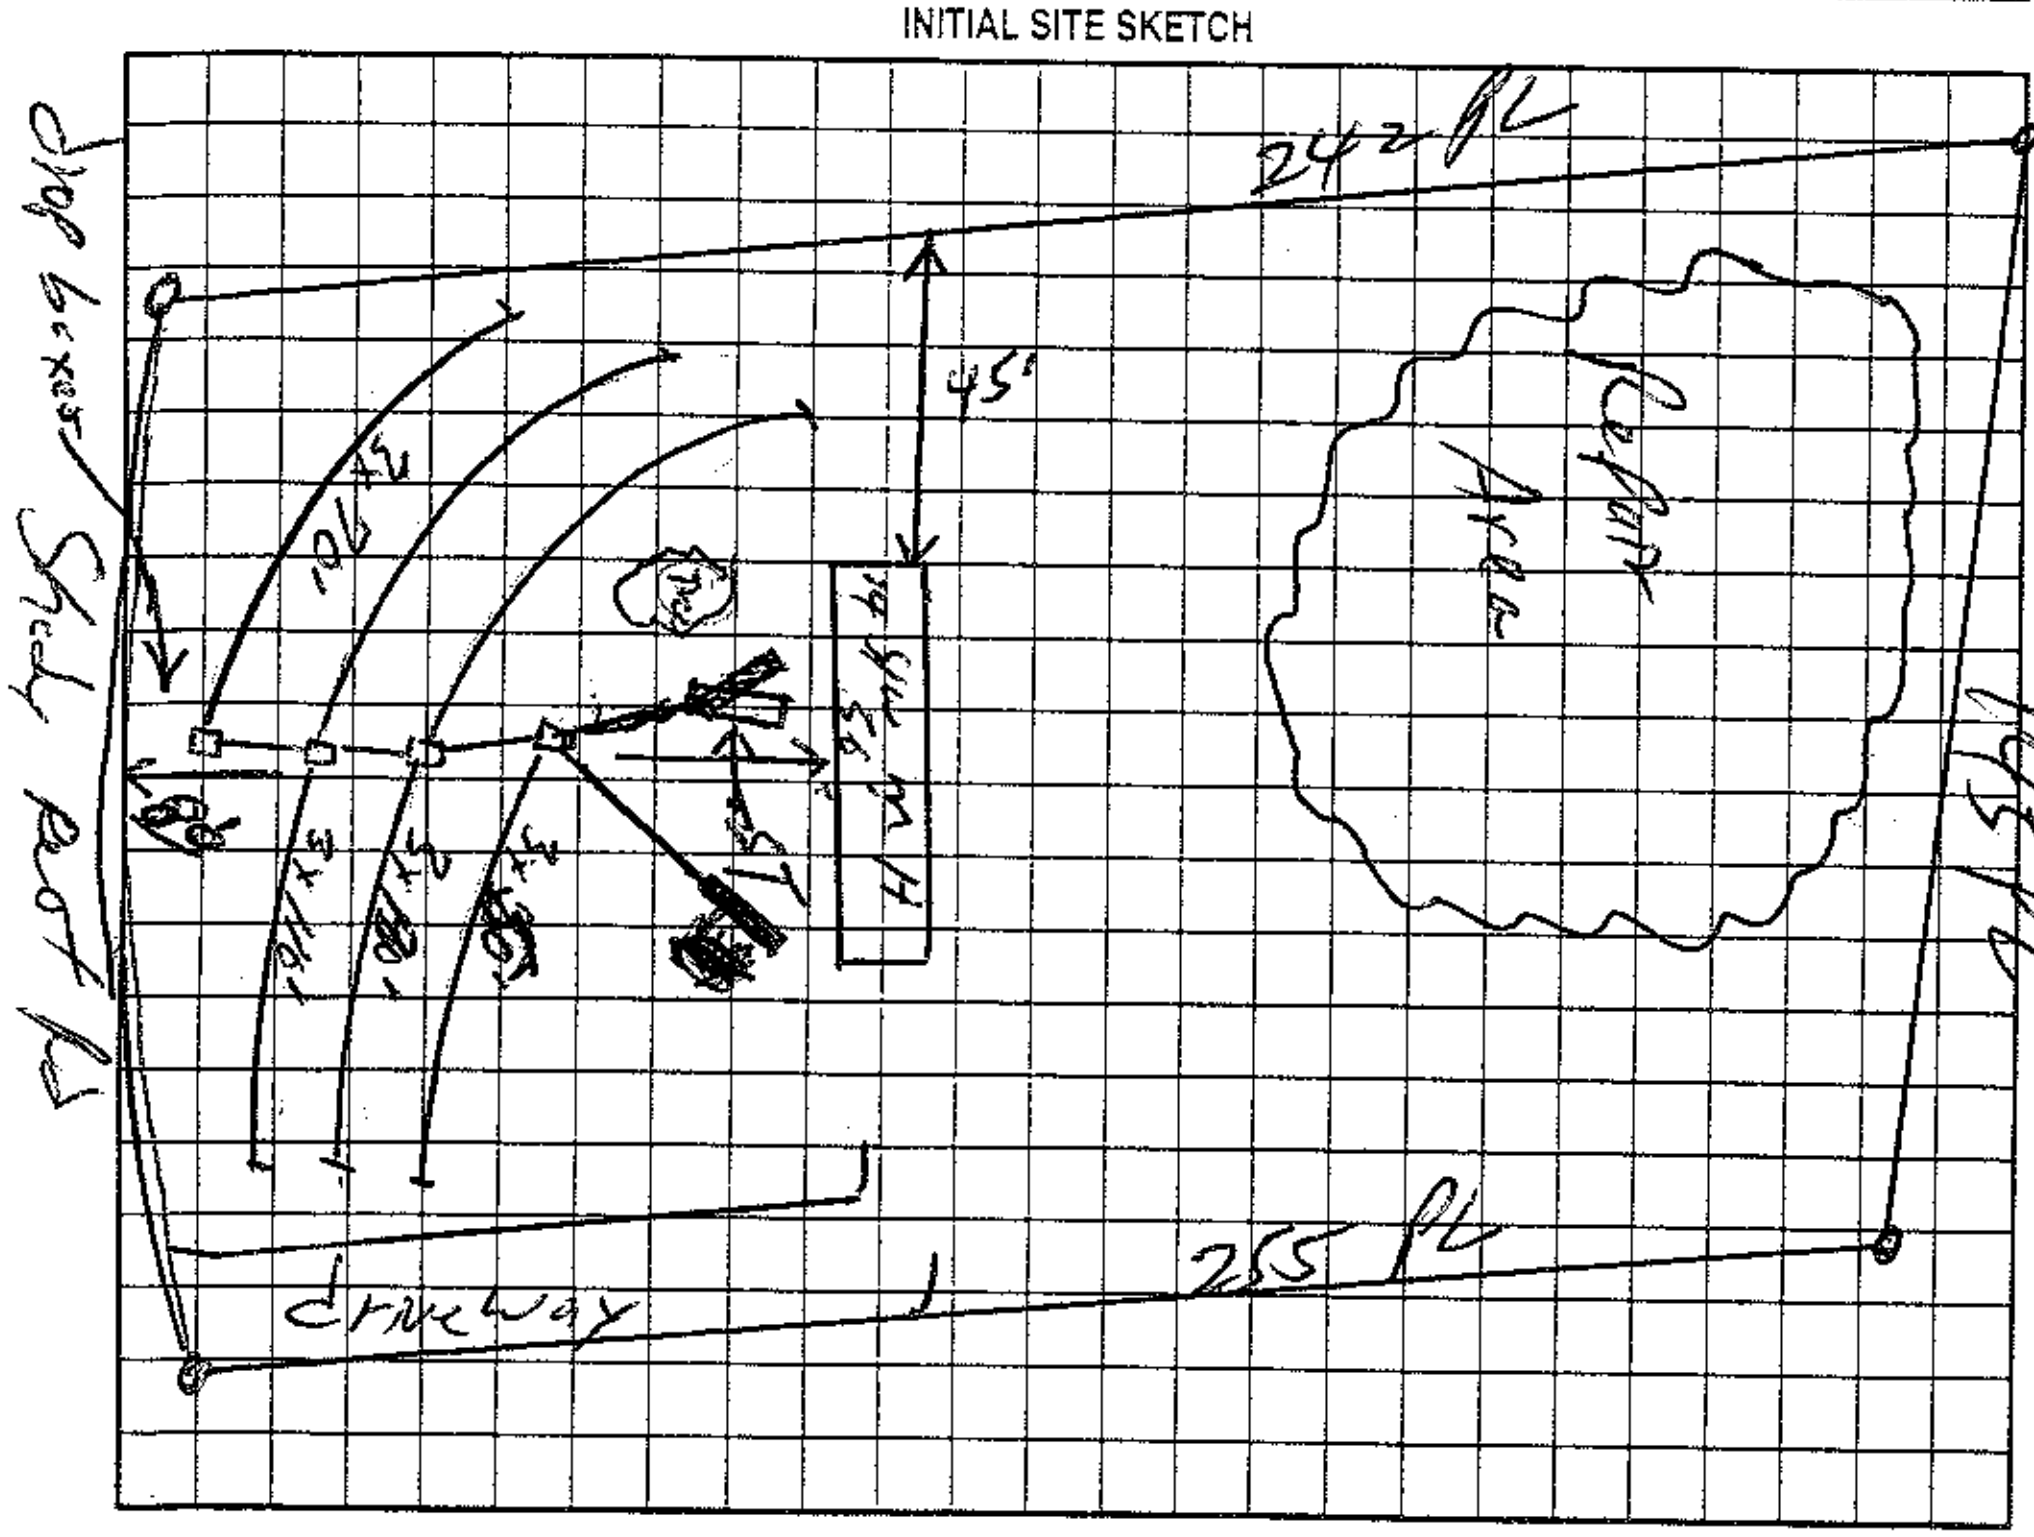

AS BUILT SKETCH

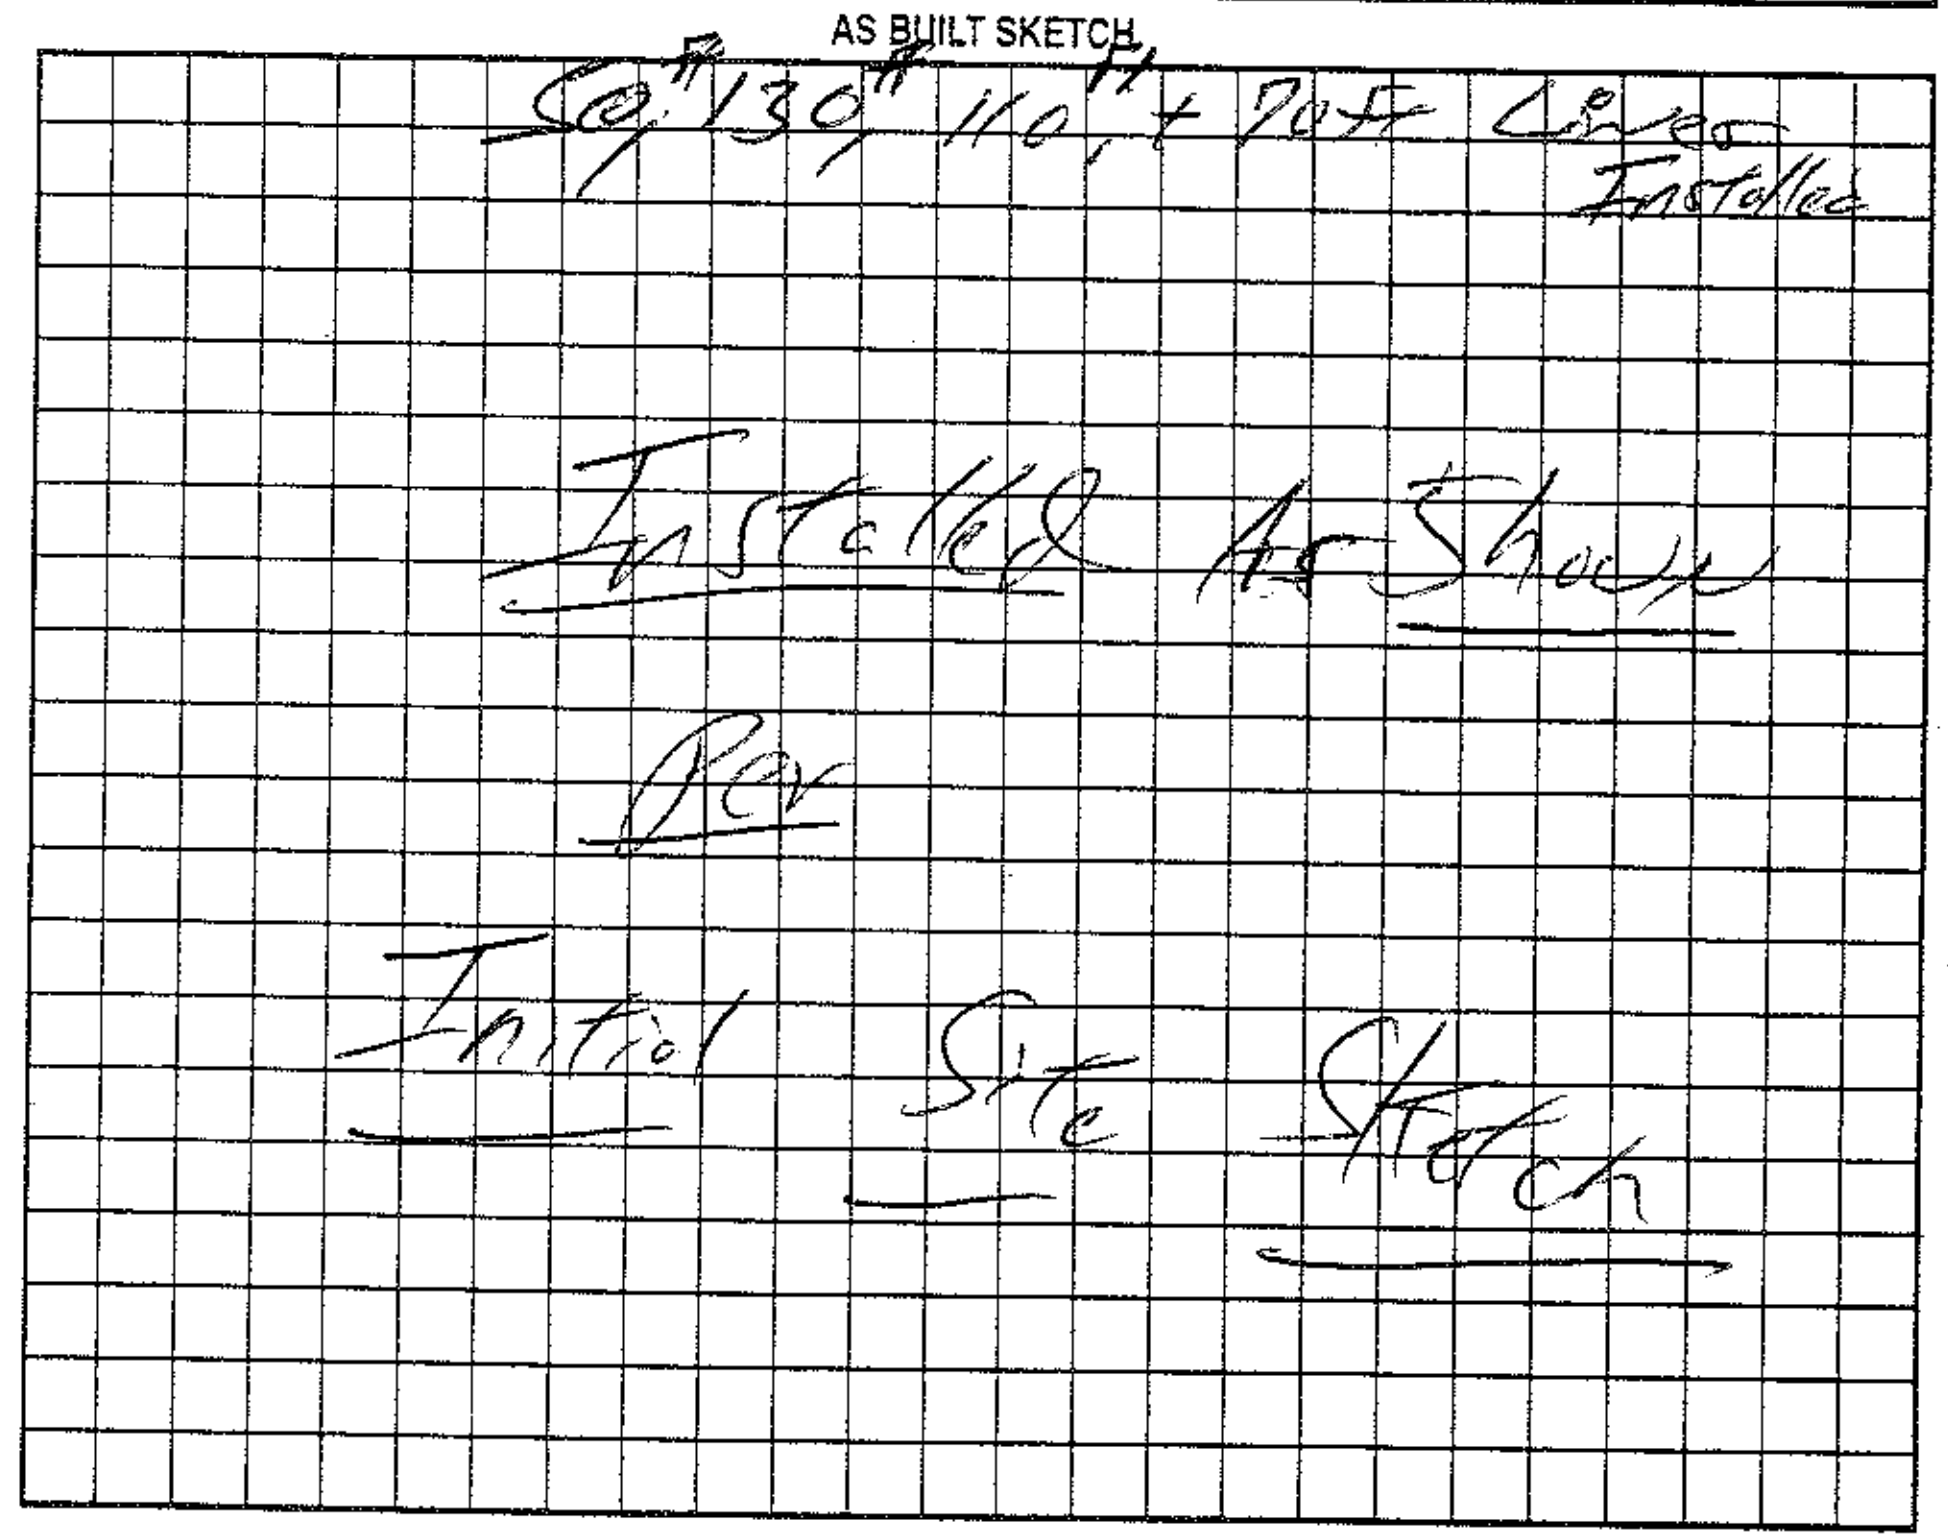

Permit can be suspended or revoked if any false information is supplied toward securing the permit/any unauthorized changes are made to the site/any unauthorized changes are made in the installation of the system. Improvement Permit with plat valid without expiration. Improvement Permit with site plan valid for sixty months. Authorization to Construct is valid for a period equal to that of Improvement Permit – not to exceed sixty months.

Signed: Michael D Estes date 10-6-03 Installed by: James Hudler

Improvement Permit by: William O. Johnson date 10/3/03 Operation Permit by: William O. Johnson date 10/6/03

Authorization to Construct by: William O. Johnson date 10/3/03 Existing System Inspection by: William O. Johnson date 10/6/03

HEALTH DEPT. COPY: WHITE OWNER COPY (FINAL): YELLOW OWNER COPY (INITIAL): PINK